


Section 19 Township 13 Range 14-W

Well No. 2 Jellison

Company McBride

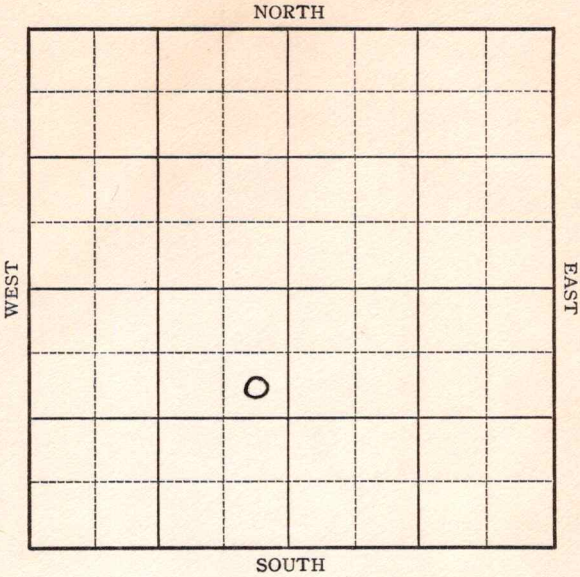

1938

2/23 8" @ 2928'.

K.C. 2928'.

T.D. 2959'.

4000 acid.

Potential 853 oil & 39 water.

COMPLETED

Map No. 72 Sec. 19 Twp. 13 R. 14WWell No. 2 JellisonMcBride

Company

Contractor

FIRST REPORT

SE NE SW

990 Ft. from N. Line Ft. from S. Line330 Ft. from E. Line Ft. from W. Line

SECTION PLAT

Location Rig up

Drilling and Remarks:

RUCT

RECORD

Cased in., ft.Sand Gas Oil Total Depth

PRODUCTION

1st 24 hrs. Nat. 1st 24 hrs. after shot Gas Cu. Ft.Dry Hole Abandoned

Date

JAN 5 - 1938H. D. Hatfield Scout

Russell KANSAS

Map No. 72 Sec. 19 Twp. 13 R. 14WWell No. 2 JellisonMcBride

Company

Contractor

COMPLETED

SE NE SW

990 Ft. from N. Line

Ft. from S. Line

330 Ft. from E. Line

Ft. from W. Line

SECTION PLAT

Location

Rig up

Drilling and Remarks:

4000 acid
LOT- 853 oil
39 wtr

RECORD

Cased 8 in., 2928 ft.Sand K.C 2928

Gas

Oil

Total Depth 2957

PRODUCTION

1st 24 hrs. Nat.

1st 24 hrs. after shot

Gas Cu. Ft.

Dry Hole

Abandoned

Date

FEB 23 1938

19

H. D. Hatfield

Scout