


Section 19 Township 13 Range 14-W

Well No. 3 Jellison

Company W. C. McBride et al

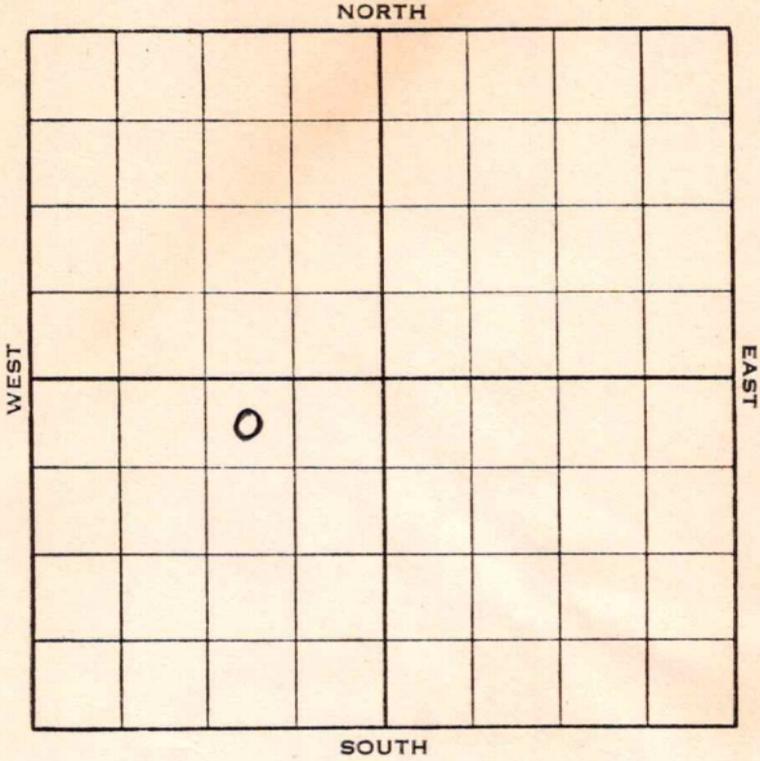

Sec. 19 Twp. 13 R. 14-W


Well No. #3 Jellison Farm
W. C. McBride et al Company

330 Ft. from N. Line

_____ Ft. from S. Line

990 Ft. from E. Line

_____ Ft. from W. Line

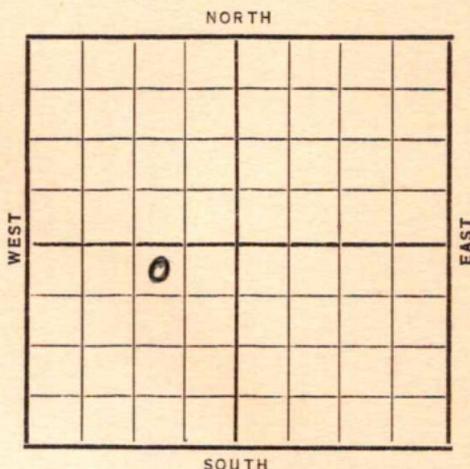

Elev. 1744

Date	REPORT
1938	
3/2	B.C.R.
3/11	R U C T
3/18	Drlg. 700'.
3/25	15" @ 284'. Anhy 809'.
	13" @ 810'. Drlg. 1500'.
4/1	Fort Riley 1693'.
	Drlg. 2265'.
4/8	Lans. 2905'. 8" @ 2916'.
	S.O. 2905-08'.
	Pay 2930-35'. 658' oil 3 hrs.
4/15	800' oil 8 hrs. 10,000 acid.
4/20	8" @ 2916'.
	K.C. 2905'.
	T.D. 2935'.
	10,000 acid.
	Potential 1294 bbls.
	COMPLETED

Map No. 72 Sec. 19 Twp. 13 R. 14W

Well No. 3 Jellison

W. C. McBride etal Company

Contractor

FIRST REPORT

SECTION PLAT

NW NE SW

330 Ft. from N. Line

_____ Ft. from S. Line

990 Ft. from E. Line

_____ Ft. from W. Line

	0		

Location _____

Rig up _____

Drilling and Remarks:

BCR

RECORD

Cased _____ in., _____ ft.

Sand _____

Gas _____

Oil _____

Total Depth _____

PRODUCTION

1st 24 hrs. Nat. _____

1st 24 hrs. after shot _____

Gas _____ Cu. Ft.

Dry Hole _____

Abandoned _____

Date

MAR 2 - 1938

19

H. D. Hatfield

Scout

Map No. 72 Sec. 19 Twp. 13 R. 14W

Well No. 3 Jellison

W. C. McBride et al Company

Contractor

COMPLETED

SECTION PLAT

NW NE SW

	0		

330 Ft. from N. Line

_____ Ft. from S. Line

990 Ft. from E. Line

_____ Ft. from W. Line

Location _____

Rig up _____

Drilling and Remarks:

10,000 acid

Lot 1294

RECORD

Cased 8 in., 2916 ft.

~~Sand~~ KC 2905

Gas _____

Oil _____

Total Depth 2935

PRODUCTION

1st 24 hrs. Nat. _____

1st 24 hrs. after shot _____

Gas _____ Cu. Ft.

Dry Hole _____

Abandoned _____

Date

APR 20 1938

19

H. D. Hatfield Scout