KANSAS


Form 51—5M—7-40—Palace

Barton

Section 17 Township 16 Range 12-W

Well No. #2 Kultgen "A"

Company Martin et al

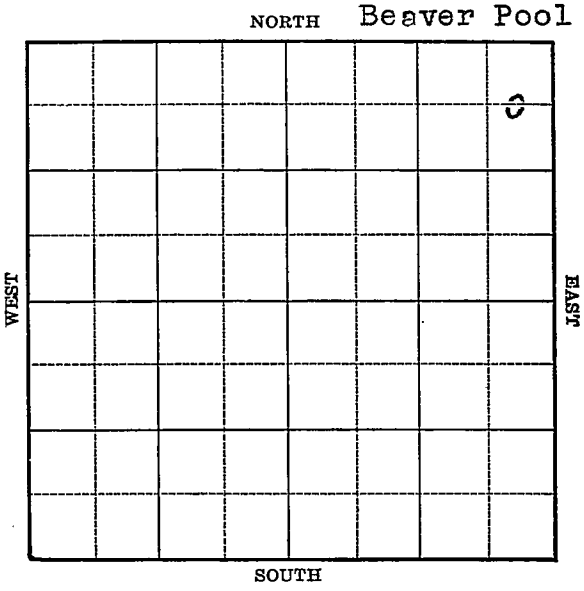

FORM 252-A 5M 2-40

KANSAS Barton

Sec. 17 Twp. 16 R. 12-W

Well No. #2 Kultgen "A" Farm

Martin et al Company


(Beaver)

660 Ft. from N. Line

Ft. from S. Line

330 Ft. from E. Line

Ft. from W. Line

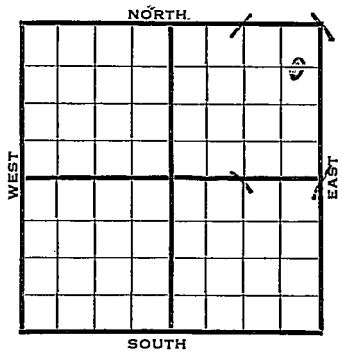

1940	REPORT
8/7	Cable
8/14	"
8/22	15" - 465' Drlg. 490'
8/29	Anhy 805' 12" - 812'
	Drlg. 1480'
9/5	S.S. Gas 1775-80' 10" - 2120'
	TD 2170' SD.
9/12	Drlg. 2550'
9/19	Topeka 2678' SSO 2925-28'
	Dodge 3000' Drlg. 3010'
9/26	Lans. 3070' 8" - 3173'
	SO 3223-30' T.D. U.R. 8".
10/3	8" - 3210' SO 3285-90'
	SO 3294-96' Basal Sand 3345-48'
	TD 3348' ,1500' oil 2 hours.
	6" - 3342' WOC.

OVER

1940
10/9 Basal sand 3341' (Corrected)
6" - 3338'
T.D. 3346'
Potential 600 bbls., pump.

COMPLETED

Form 26—200 Bks.—1-40—Palace Barton KANSAS

Map No. 55 Sec. 17 Twp. 16 R. 12W

Well No. 2 Kultgen "A"

Martin etal Company

Contractor

FIRST REPORT

C E L NE NE

660 Ft. from N. Line


Ft. from S. Line

330 Ft. from E. Line

Ft. from W. Line

BEAVER POOL

SECTION PLAT

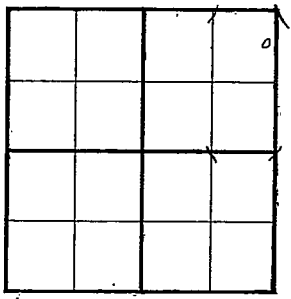

Location

Rig up

Drilling and Remarks:

Cable

RECORD

Cased in., ft.

Sand

Gas

Oil

Total Depth

PRODUCTION

1st 24 hrs. Nat.

1st 24 hrs. after shot

Gas Cu. Ft.

Dry Hole

Abandoned

Date

AUG 7 1940 19

S. J. LEWIS Scout

Form 26—200 Bks.—1-40—Palace Barton KANSAS

Map No. 55 Sec. 17 Twp. 16 R. 12W

Well No. 2 Kultgen "A"

Martin etal Company

Contractor

COMPLETED

C E L NE NE

660 Ft. from N. Line


_____ Ft. from S. Line

330 Ft. from E. Line

_____ Ft. from W. Line

BEAVER POOL

SECTION PLAT

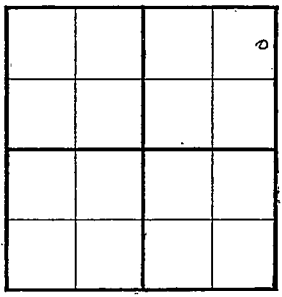

Location_____

Rig up_____

Drilling and Remarks:

Basal C & L 3341

Corrected.

6" C 3338

Pump 600 B.B.L.

RECORD

Cased _____ in., _____ ft.

Sand_____

Gas_____

Oil_____

Total Depth 3346

PRODUCTION

1st 24 hrs. Nat._____

1st 24 hrs. after shot_____

Gas_____ Cu. Ft.

Dry Hole_____

Abandoned_____

Date

OCT 9 1940 19____ S. J. LEWIS Scout