


Section 19 Township 13 Range 14-W

Well No. #6 Jellison

Company W. C. McBride Inc.

NORTH Atherton Pool

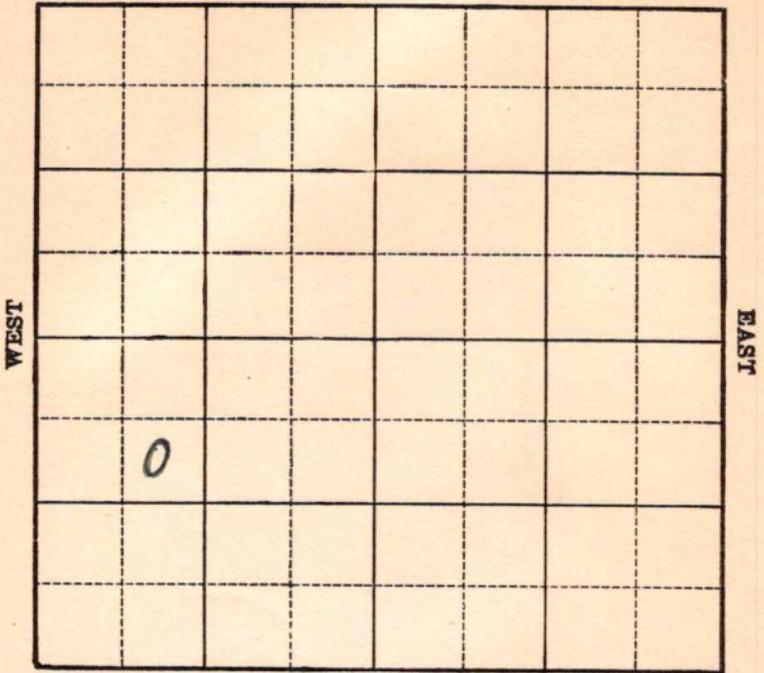

SOUTH

Sec. 19 Twp. 13 R. 14-W

Well No. #6 Jellison Farm

W. C. McBride Inc. Company


(Atherton)

990 Ft. from N. Line

Ft. from S. Line

Ft. from E. Line

990 Ft. from W. Line

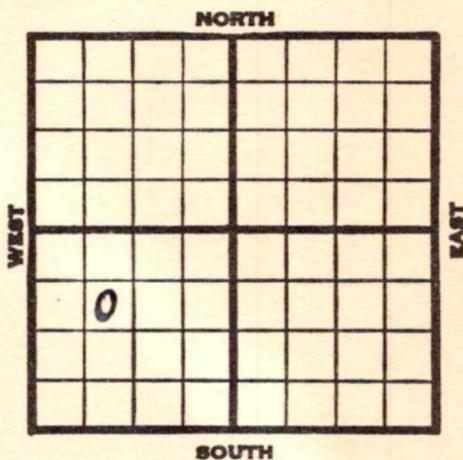

Elev. 1827

| 1940 | REPORT |
|------|-------------------------------|
| 2/21 | S. H. |
| 2/29 | 8" - 589' Anhy 865' |
| | Drlg. 1950' |
| 3/8 | Lansing 2991' Drlg. 3200' |
| 3/14 | Arb. 3254' 5" - 3254' |
| | T.D. 3271' 150' oil 3 hours. |
| | 1000 acid. |
| 3/20 | Arb. 3254' |
| | 5" - 3254' |
| | 1000 acid. |
| | T.D. 3271' |
| | Potential 137 bbls., on pump. |
| | |
| | COMPLETED |
| | |
| | |
| | |
| | |
| | |
| | |

Map No. 72 Sec. 19 Twp. 13 R. 14W

Well No. 6 Jellison

W. C. McBride Inc. Company

Contractor

FIRST REPORT

SE NW SW

SECTION PLAT

990 Ft. from N. Line

| | | | |
|--|--|--|--|
| | | | |
| | | | |
| | | | |
| | | | |

_____ Ft. from S. Line

_____ Ft. from E. Line

990 Ft. from W. Line

ATHERTON POOL

Location _____

RECORD

Rig up _____

Drilling and Remarks:

S.H.

Cased _____ in., _____ ft.

Sand _____

Gas _____

Oil _____

Total Depth _____

PRODUCTION

1st 24 hrs. Nat. _____

1st 24 hrs. after shot _____

Gas _____ Cu. Ft.

Dry Hole _____

Abandoned _____

Date

FEB 21 1940 19

S. J. LEWIS Scout

Russell

KANSAS

Map No. 72 Sec. 19 Twp. 13 R. 14W

Well No. 6 Jellison

W. C. McBride Inc. Company

Contractor

COMPLETED

SE NW SW

SECTION PLAT

990 Ft. from N. Line

_____ Ft. from S. Line

_____ Ft. from E. Line

990 Ft. from W. Line

| | | | |
|--|---|--|--|
| | | | |
| | | | |
| | o | | |
| | | | |

ATHERTON POOL

Location _____

Rig up _____

Drilling and Remarks:

Ar 83254
5" @ 3254
1000 acil
Pump 137 P.J.

RECORD

Cased _____ in., _____ ft.

Sand _____

Gas _____

Oil _____

Total Depth 3271

PRODUCTION

1st 24 hrs. Nat. _____

1st 24 hrs. after shot _____

Gas _____ Cu. Ft.

Dry Hole _____

Abandoned _____

Date

MAR 20 1940 19

S. J. LEWIS

Scout