


Section 17 Township 16 Range 12W

Well No. #1 Kultgen "F"

Company Franco Central

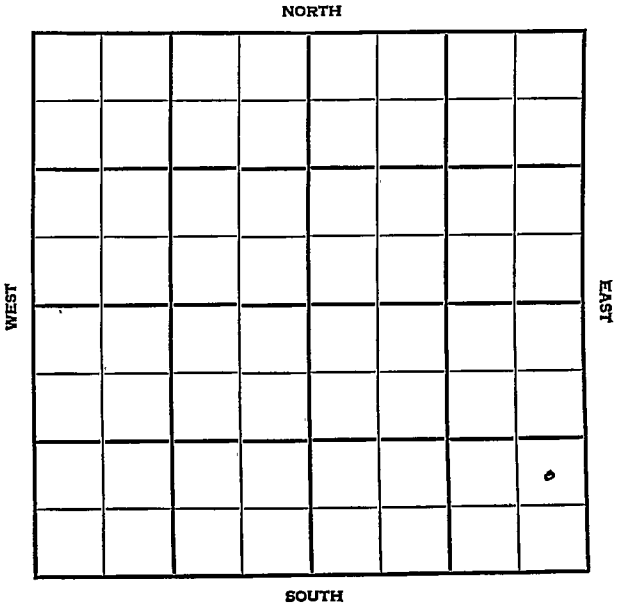

Barton KANSAS

SEC.	TWP.	R.
17	16	12W


WELL NO. 1 Kultgen "F" FARM

COMPANY Franco Central

CONTRACTOR Lewis Drlg.

Kraft-Prusa Pool

\_\_\_\_\_ Ft. from N. Line  
 990 \_\_\_\_\_ Ft. from S. Line  
 330 \_\_\_\_\_ Ft. from E. Line  
 \_\_\_\_\_ Ft. from W. Line

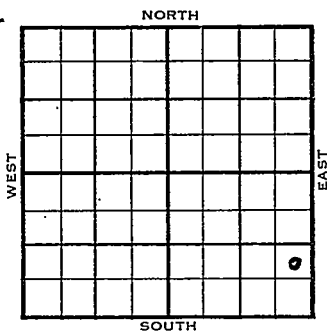

NE SE SE

1955	ELEVATION	REPORT
	1916'	

2/2

D&A  
 TD 3388'  
 Spud 1-21-55  
 8" @ 357'  
 Heeb. 2983', Br. Lime 3071', KC 3083',  
 Chert 3361'  
 DST 3090-3125', opn 1 hr., rec. 40'  
 muddy SW, 690#  
 TD 3388'  
 D&A

**FIRST REPORT**

**ABANDONED**

