

Beaton

KANSAS

SECTION 17 TOWNSHIP 16 RANGE 12 W

WELL NO. #2 Zorn

COMPANY Franco-Central

NORTH

		0					

WEST

EAST

SOUTH

Barton

KANSAS

SEC. 17	TWP. 16	R. 12W
------------	------------	-----------

WELL NO. ~~#####~~ #2 Zorn FARM

COMPANY

Franco-Central

CONTRACTOR  
Lewis


Beaver

\_\_\_\_\_ Ft. from N. Line

\_\_\_\_\_ Ft. from S. Line

\_\_\_\_\_ Ft. from E. Line

\_\_\_\_\_ Ft. from W. Line

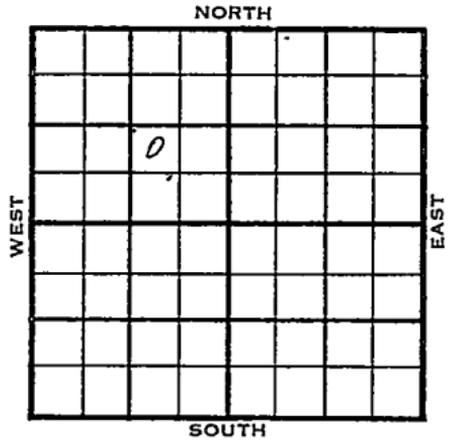

NW SE NW

1956	ELEVATION	REPORT
------	-----------	--------

1-25	Location	
------	----------	--

County Barton Elev. \_\_\_\_\_  
 Sec. 17 Twp. 16N Rge. 12W  
 Company Franco-Central  
 FarmName Zorn No. 2

TOPS	DEPTH	LOG	DATUM	Loc. in Sec.
Anh.				NW SE NW
Ip.				
H.				
Tr.				
Dg.				
Bl.				
L.				Geol. _____
K.C.				Contr. _____
B.K.C.				
Ce.				<u>Lewis</u>
C.				
M.				Pool _____
M.				<u>Beaver</u>
K.				
Mz.				
Me.				
V.				
S.				
S.				
A.				
R.				
Pe.				
G.				
T.D.				

JAN 25 '56  
 0  
 FIRST REPORT

Date Comm. \_\_\_\_\_  
 Location \_\_\_\_\_

*[Handwritten signature]*

Co.  
 Use.  
 No.  
 Sec.  
 T.  
 R.

County Barton Elev. 1881  
 Sec. 17 Temp. (16) Rge. 12W  
 Company Franco-Central  
 Farm Name Zorn No. 2

TOPS	DEPTH	LOG	DATUM	Loc. in Sec.
Ant.				NW SE NW
Tp.				800' FSL
H.	2974			800' FEL & NW 1/4
Tr.				
Dg.				
Bl.	3059			
L.	3072		1191	Geol.
K.C.				Contr.
B.K.C.				
Ce.				Lewis
C.	3312		1431	Pool
M.				Beaver
M.				
K.				
Mr.				
Mo.				
V.				
S.				
S.				
A.				
R.				
Pe.				
G.				
TD	3381			ABANDONED

Date Comm. FEB 15 1956  
 Location FEB 1 '56 1-30-56 8 1/2 S. 329  
FEB 8 '56 3145 FEB 16 '56

*Handwritten signature or initials*