
FORM 51 10M 2-49 PETROL

KANSAS

Section 18 Township 16 Range 12-W

Well No. #1 Sandeinger

Company Derby Drlg.

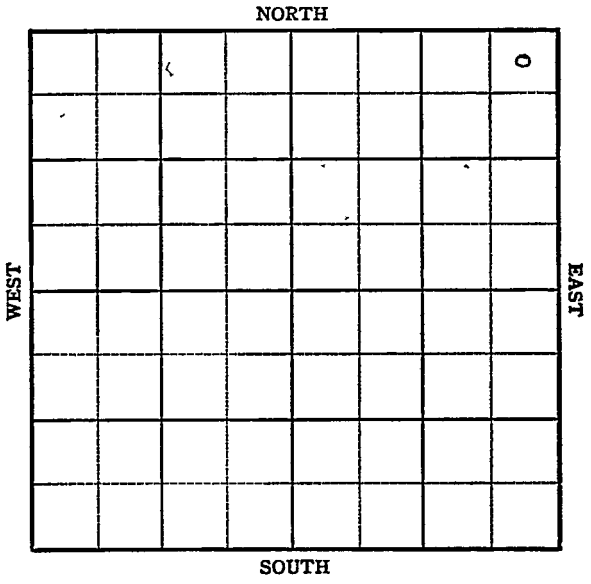

FORM 252-B
10M 9-49 PETROL

Barton KANSAS

Sec. 18 Twp. 16 R. 12W

Well No. #1 Sandeinger Farm

Derby Drlg. Company

Derby Contractor


330' Ft. from N. Line

Ft. from S. Line

330' Ft. from E. Line

Ft. from W. Line

NE NE NE

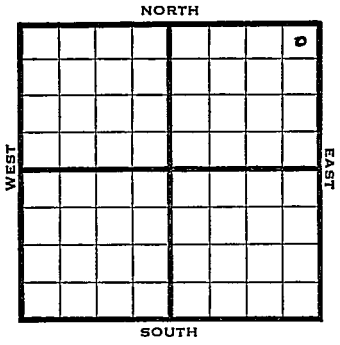


1950 Elev 1863 REPORT

5/10 Spud 5-6-50
8" @ 190'
Anhyy 811-30
Drlg. 835'

5/24 TD 3416
8" @ 109
Anhy 811-30
Topeka 2654
Heebner 2972
Lans 3062
Cong 3331
Arb 3396
TD 3416
D&A

**ABANDONED**

Form 26 200 Bks. 11-49 Petrol

Kansas Beaver

Map No. Sec. 18 Twp. 16 R. 12W

Well No. 1 Sandeinger

Derby Drlg. Company

Derby Contractor

NE NE NE


330 Ft. from N. Line

Ft. from S. Line

330 Ft. from E. Line

Ft. from W. Line

SECTION PLAT

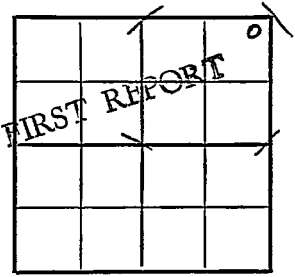


Barton

Location

Rig up

Drilling and Remarks:

Spud 5-6-50
8" @ 19[illegible]
Anhy. 811-30
Drlg. 835

RECORD

Cased in., ft.

Sand

Gas

Oil

Total Depth

PRODUCTION

1st 24 hrs. Nat.

1st 24 hrs. after shot

Gas Cu. Ft.

Dry Hole

Abandoned

Date

MAY 10 1950

19

J. E. TYRA

Scout

Form 26 200 Bks. 11-49 Petrol

Kansas

Map No. Sec. 18 Twp. 16 R. 12W


Well No Standinger

Derby Drlg. Company

Contractor

NE NE NE El. 1863

SECTION PLAT

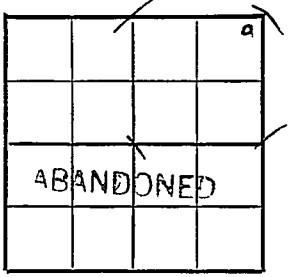


330 Ft. from N. Line

Ft. from S. Line

330 Ft. from E. Line

Ft. from W. Line

Barton

Location

Rig up

Drilling and Remarks:

8" @ 190
anhy 811-30
Topeka 2654
Kleebner 2972
Lans. 3062
Cong. 3331
Arb. 3396
T.D. 3416

RECORD

Cased in., ft.

Sand

Gas

Oil

Total Depth 3416

PRODUCTION

1st 24 hrs. Nat.

1st 24 hrs. after shot

Gas Cu. Ft.

Dry Hole

Abandoned

D+A

Date

MAY 24 1950 19 J. E. TYRA Scout