


Section 19 Township 13 Range 14-W

Well No. #5 Jellison

Company W. C. McBride

NORTH **Atherton Pool**

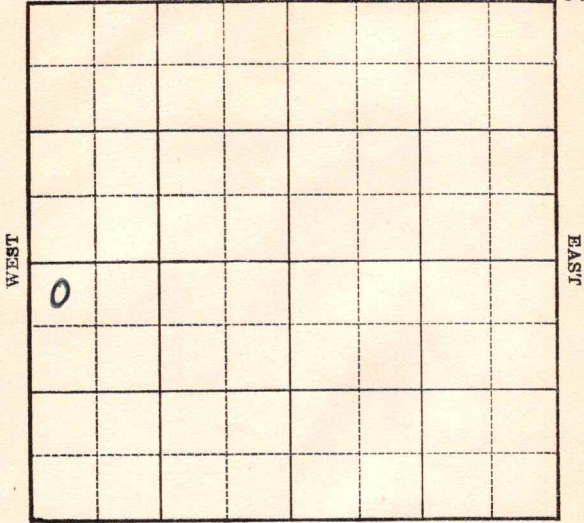



1940

1/31

Arb. 3258'

5" - 3259'

T.D. 3270'

3600 acid.

Depthograph potential 845 bbls.

Show water.

COMPLETED

Map No. 72 Sec. 19 Twp. 13 R. 14W

Well No. 5 Jellison

W. C. McBride

Company

Contractor

FIRST REPORT

SECTION PLAT

NW SW

330 Ft. from N. Line

\_\_\_\_\_ Ft. from S. Line

\_\_\_\_\_ Ft. from E. Line

330 Ft. from W. Line

o			

ATHERTON POOL

Location \_\_\_\_\_

Rig up \_\_\_\_\_

Drilling and Remarks:

Cable

RECORD

Cased \_\_\_\_\_ in., \_\_\_\_\_ ft.

Sand \_\_\_\_\_

Gas \_\_\_\_\_

Oil \_\_\_\_\_

Total Depth \_\_\_\_\_

PRODUCTION

1st 24 hrs. Nat. \_\_\_\_\_

1st 24 hrs. after shot \_\_\_\_\_

Gas \_\_\_\_\_ Cu. Ft.

Dry Hole \_\_\_\_\_

Abandoned \_\_\_\_\_

Date

NOV 28 1939 19

S. J. LEWIS Scout

Map No. 72 Sec. 19 Twp. 13 R. 14W

Well No. 5 Jellison

W. C. McBride Company

Contractor

COMPLETED

SECTION PLAT

NW SW

330 Ft. from N. Line

\_\_\_\_\_ Ft. from S. Line

\_\_\_\_\_ Ft. from E. Line

330 Ft. from W. Line

0			

ATHERTON POOL

Location \_\_\_\_\_

Rig up \_\_\_\_\_

Drilling and Remarks:

*Ca 83258*

*5" 83259*

*3600 acid*

*Depthograph Port.*

*845 Show water*

RECORD

Cased \_\_\_\_\_ in., \_\_\_\_\_ ft.

Sand \_\_\_\_\_

Gas \_\_\_\_\_

Oil \_\_\_\_\_

Total Depth 3270

PRODUCTION

1st 24 hrs. Nat. \_\_\_\_\_

1st 24 hrs. after shot \_\_\_\_\_

Gas \_\_\_\_\_ Cu. Ft.

Dry Hole \_\_\_\_\_

Abandoned \_\_\_\_\_

Date

JAN 31 1940 19

S. J. LEWIS Scout