
FORM 51 5M 2-38 TPCO.

Barton KANSAS

Section 17 Township 16 Range 12-W

Well No. 1 Kultgen "B"

Company Martin & Hearing

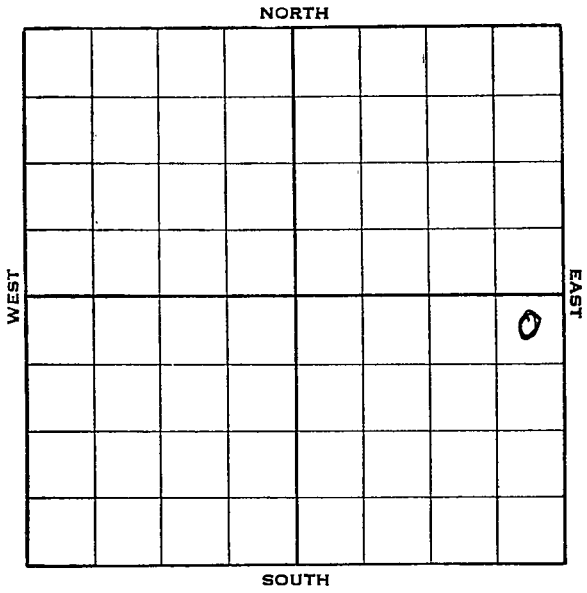

FORM 252-A 5M 1-38 KANSAS Barton

Sec. 17 Twp. 16 R. 12-W

Well No. #1 Kultgen "B" Farm

Martin & Hearing Company


330 Ft. from N. Line

Ft. from S. Line

330 Ft. from E. Line

Ft. from W. Line

Elev. 1912'

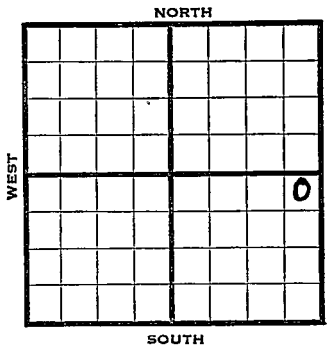

1938	REPORT
6/8	Cellar.
6/17	C.R.
6/24	R. U.
7/1	20" - 70' Drlg. 525'.
7/8	15" - 544'. Anhy. 813'.
	12" - 813'. Drlg. 1415'.
7/15	Dlg. 1990'.
7/22	10" - 2115'. Dlg. 2455'.
7/29	Topeka 2698'. Dlg. 2800'.
8/5	8" - 2980'. S.S.O. 2990-95'.
	Dlg. 3170'.
8/12	Sandy Cong. 3333'.
	T. D. 3342'. 2700' oil in 48
	hours. 6" - 3328'. WOC.
8/19	Basal sand 3342'. T.D. 3349'.
	2200' oil in 24 hrs.

OVER

1938

8/24 6" at 3328'.

Basal 3342'.

T. D. 3349'.

Pump 119 bbls. 4 hrs. & 109 bbls. 4 hrs.

Potential 655 bbls.

COMPLETED

Form 26—1M Bks.—2-29 Barton KANSAS

Map No. 55 Sec. 17 Twp. 16 R. 12W

Well No. 1 Kultgen "B"

Martin & Hearing Company

Contractor

FIRST REPORT

NE SE


330 Ft. from N. Line

Ft. from S. Line

330 Ft. from E. Line

Ft. from W. Line

SECTION PLAT

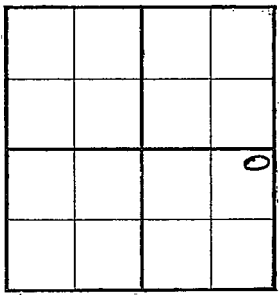

Location

Rig up

Drilling and Remarks:

Cellar

RECORD

Cased in., ft.

Sand

Gas

Oil

Total Depth

PRODUCTION

1st 24 hrs. Nat.

1st 24 hrs. after shot

Gas Cu. Ft.

Dry Hole

Abandoned

Date

JUN 8 - 1938 19

H. D. Hatfield Scout

Form 26—1M Bks.—2-29 Barton KANSAS

Map No. 55 Sec. 17 Twp. 16 R. 12W

Well No. 1 Kultgen "B"

Martin & Hearing Company

Contractor

COMPLETED

NE SE


330 Ft. from N. Line

Ft. from S. Line

330 Ft. from E. Line

Ft. from W. Line

SECTION PLAT

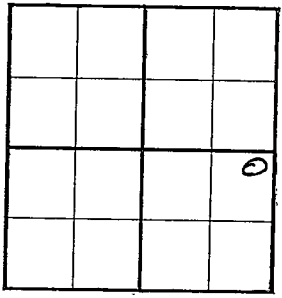

Location

Rig up

Drilling and Remarks:

P-119/4 + 109/4

Pot 655

RECORD

Cased 6 in., 3328 ft.

Sand Basal 3342

Gas

Oil

Total Depth 3349

PRODUCTION

1st 24 hrs. Nat.

1st 24 hrs. after shot

Gas Cu. Ft.

Dry Hole

Abandoned

Date

AUG 24 1938 19 H. D. Hatfield Scout