

KANSAS


FORM 51 IOM 12-46 PETROL

Barton

Section 17 Township 16 Range 12-W

Well No. #1 Kultgren

Company Black-Marshall

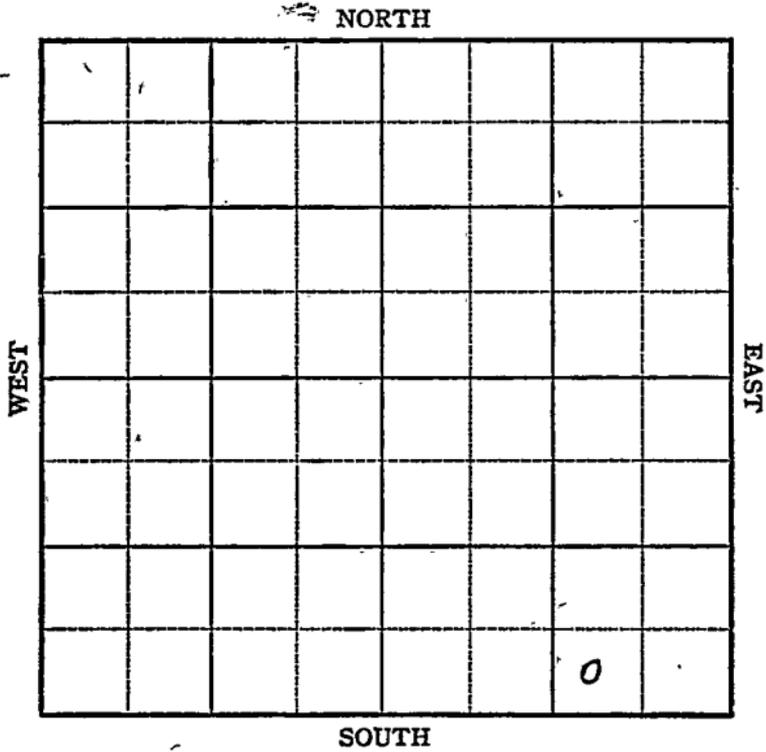

KANSAS

Barton ✓

Sec. 17 Twp. 16 R. 12-W

Well No. #1 Kultgren Farm


Black-Marshall Company
Kraft-Prusa

Ft. from N. Line

330 Ft. from S. Line

990 Ft. from E. Line

Ft. from W. Line

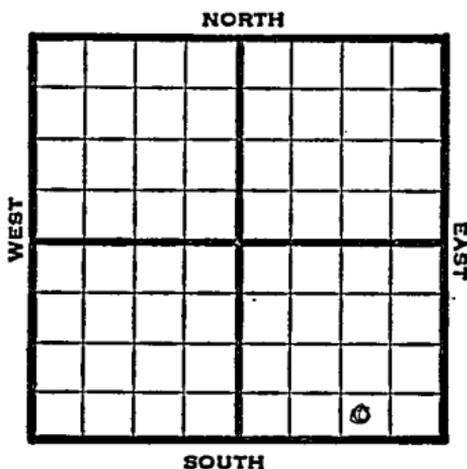

SW SE SE

REPORT

1947 / 1910

- 2/19 Rig
- 2/26 "
- 3/4 "
- 3/12 Rig
- 3/18 12" @ 446'
Drlg 530'
- 3/25 1935'
- 4/2 8" @ 2121'
Drlg. 2290'.
- 4/9 Drlg 2510'
- 4/15 8" @ 2515'
Drlg. 2570'
- 4/23 Lans 3070
6" @ 3130'
Drlg 3155'
- 4/30 Reagan 3314
Quartzite 3355
TD 3375'
ABANDONED

Map No. 55 Sec. 17 Twp. 16 R. 12W

Well No. 1 Kultgren

Black-Marshall

Company

ABANDONED

Contractor

SW SE SE

E. 190

SECTION PLAT

_____ Ft. from N. Line
330 Ft. from S. Line
990 Ft. from E. Line
_____ Ft. from W. Line

			0

Barton County

Location _____

Rig up _____

Drilling and Remarks:

*Reagan 3314
Luarzite 3355*

RECORD

Cased _____ in., _____ ft.

Sand _____

Gas _____

Oil _____

Total Depth 3325

PRODUCTION

1st 24 hrs. Nat. _____

1st 24 hrs. after shot _____

Gas _____ Cu. Ft.

Dry Hole _____

Abandoned _____

Date

APR 30 1947 19

S. J. LEWIS Scout