


Section 19 Township 13 Range 14W

Well No. ~~#1~~ #7 Jellison "A"

Company Abe Steko II
~~Sam Shame~~

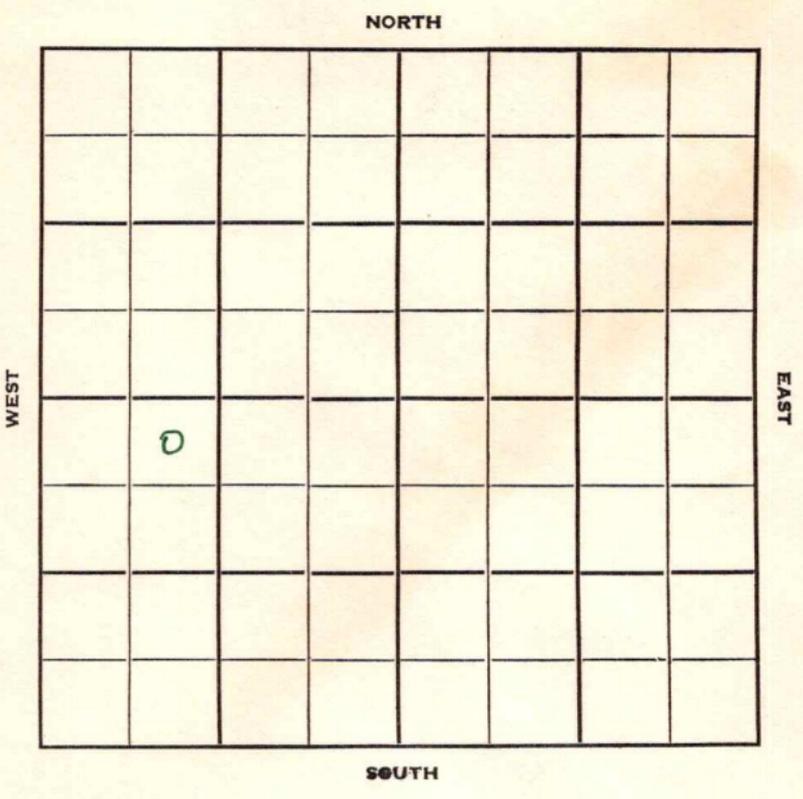

Russell

Sec. 19 Twp. 13 R. 14W

Well No. ~~#1~~ #7 Jellison "A" Farm

Abe Stekoll
Sam Shane Company

Sidey Contractor

Atherton Pool


330' Ft. from N. Line

..... Ft. from S. Line

..... Ft. from E. Line

990' Ft. from W. Line

NE NW SW

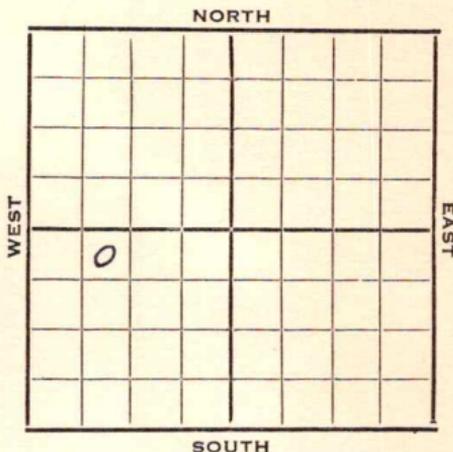

1951 **Elev. 1819'** REPORT

11/28 Drlg.

1952
1/23

Spud 11-26-51
 Oil well TD 3260' 8" @ 240'
KC 2979'
 DST 2981-3040 open 1 hr. rec 150' SO
 CM, 180' water
Arb. 3249'
 DST 3254-60 open 1 hr. rec 45' MCO
 5" @ 3254' **Tor. 2945'** **Marm. 3197'**
 CO to 3260' FU 1800' oil 2 hr.
 S/15 BOPH 4 hr.
 Comp. 50 BOPD 6% water.

COMPLETED

County Russell State Kansas

Sec. 19 (Blk. 13 (Twp.)) (Sur. 14W (Rge.)) Map No.

Operator ~~Sam Shane~~ Abe Stekoll

Well No. 57 Farm Jellison "A"

Elev. 1819 Location NE NW SW

330 Ft. From N Line SW

990 Ft. From W Line Quarter

Ist. Report

Completion JAN 23 1952

Remarks Atherton Pool
Sidey - Contr.

Spudding Date 11-26-51

Drlg. Data Oil well TD 3260

8" @ 240 KC 2979 DST 2981-3040

open 1 hr. Rec. 150' socm 180' water

Arb. 3249 DST 3254-60 open 1 hr.

Rec. 45' mco 5" @ 3254 Tor. 2945

Marm. 3197 CO to 3260 FU 1800' oil

2 hr. S/ 15 boph 4 hr.

Comp. 50 bopd 6% water

*Corrected
Corrected
from #1 to
5*

Kansas

Map No. _____ Sec. 19 Twp. 13 R. 14W

Well No. 1 Jellison "A"

Abe Stekoll Company

CORRECTION Contractor

NE NW SW

SECTION PLAT

330 Ft. from N. Line

_____ Ft. from S. Line

_____ Ft. from E. Line

990 Ft. from W. Line

0			

Russell County

RECORD

Location _____

Cased _____ in., _____ ft.

Rig up _____

Sand _____

Drilling and Remarks:

Gas _____

Oil _____

Reported

Total Depth _____

#5 Jellison

PRODUCTION

Sam Shane

1st 24 hrs. Nat. _____

1st 24 hrs. after shot _____

Gas _____ Cu. Ft.

Dry Hole _____

Abandoned _____

Date

DEC 5 1951 19

J. E. TYRA

Scout