


Russell

Section 19 Township 13 Range 14-W

Well No. 2 R. F. Wineteer

Company Phillips

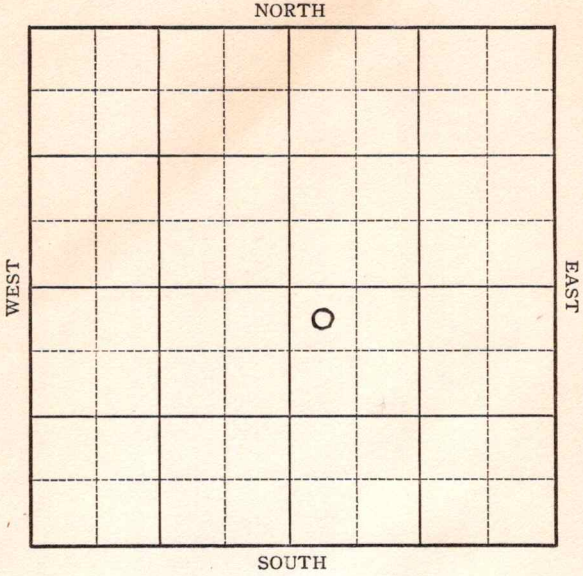

Sec. 19 Twp. 13 R. 14-W

Well No. #2 R. F. Wineteer Farm

Phillips Company


330 Ft. from N. Line

_____ Ft. from S. Line

_____ Ft. from E. Line

330 Ft. from W. Line

Elev. 1839

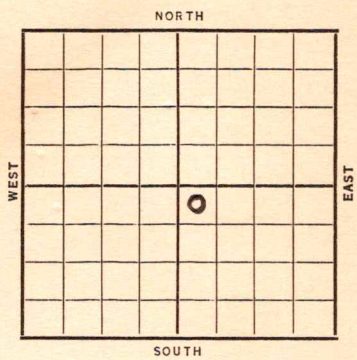

Date	REPORT
1937	
11/3	Location
11/12	Cellar.
11/19	"
11/26	"
12/3	R. U. C. T.
12/10	Drlg. 185'.
12/17	15" @ 394'. Drlg. 403'.
12/24	Anhy 886' . SD @ 896'.
12/30	12" @ 895'. Drlg. 1150'.
1938	
1/7	Drlg. 2115'.
1/14	10" @ 2474'. Drlg. 2525'.
1/20	S.O. 2718-20
	K.C. 3000' S.O. 3010-13'
	HFW 3040-52 U.R. 8"
1/28	8" - 3058' Arb. 3267'
	7" - 3268' T.D. 3270'
	S.O. WOC
2/4	T.D. 3283' 2160' oil in 12 hrs.
	Swb 252 oil & no water in 11 hrs.

OVER

1938

2/11 T.D. 3283'.
Will treat.

2/18 1500 acid. Testing.

2/23 7" @ 3268'.
Arb. 3267'.

T.D. 3283'.

2000 acid.

Potential 1050 bbls.

No water.

COMPLETED

Russell

KANSAS

Map No. _____ Sec. 19 Twp. 13 R. 14W

Well No. 2 R. F. Wineteer

Phillips

Company

Contractor

FIRST REPORT

SECTION PLAT

NW SE

330 Ft. from N. Line

_____ Ft. from S. Line

_____ Ft. from E. Line

330 Ft. from W. Line

		0	

Location X

Rig up: _____

Drilling and Remarks:

RECORD

Cased _____ in., _____ ft.

Sand _____

Gas _____

Oil _____

Total Depth _____

PRODUCTION

1st 24 hrs. Nat. _____

1st 24 hrs. after shot _____

Gas _____ Cu. Ft.

Dry Hole _____

Abandoned _____

Date

NOV 3 1937 19

H. D. Hatfield Scout

Map No. 72 Sec. 19 Twp. 13 R. 14W

Well No. 2 R. F. Wineteer

Phillips Company

Contractor

COMPLETED

NW SE

330 Ft. from N. Line

_____ Ft. from S. Line

_____ Ft. from E. Line

330 Ft. from W. Line

SECTION PLAT

		0	

Location _____

Rig up _____

Drilling and Remarks:

2000 acid

POT 1050

NO WT

RECORD

Cased 7 in., 3268 ft.

Sand Arb 3267

Gas _____

Oil _____

Total Depth 3283

PRODUCTION

1st 24 hrs. Nat. _____

1st 24 hrs. after shot _____

Gas _____ Cu. Ft.

Dry Hole _____

Abandoned _____

Date

FEB 23 1938

19

H. D. Hatfield

Scout