

Russell

Form 252-A
5M 4-32 MPC

Map No. **KANSAS** Sec. 21 Twp. 13 R. 14W


Well No. 1 Burrell Farm
Tom Palmer, Company

330 Ft. from N. Line

_____ Ft. from S. Line

330 Ft. from E. Line

_____ Ft. from W. Line

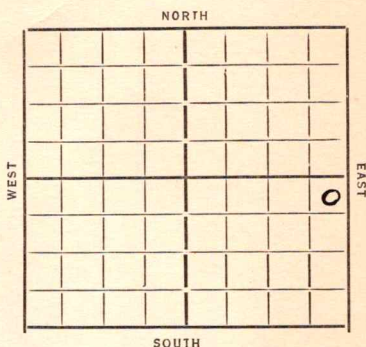

Date 1934

REPORT

3/7 Celler

3/15 — 3/22 — 3/29 —

4/5 Rign

4/12 Rign up

4/19 15" 368

4/26 Dlg 745 12" 649

5/3 " 850

5/10 " 2115

5/18 " 2715 10" 2460

5/25 " 3095

5/31 Show oil 3205 5" at 3268
Top Pay oil 3278 to 81 HFO.

6/7 Tubing

6/14 Pumped 692 Bbls.

6/21 _____

6/27 Silicious 3278 TD 3281
692 Bbls.

COMPLETED

Map No. 72 Sec. 21 Twp. 13 R. 14W

Well No. 1-Barrill

Tom Palmer Company

Contractor

SECTION PLAT

330 Ft. from N. Line
..... Ft. from S. Line
330 Ft. from E. Line
..... Ft. from W. Line

			0

Location.....

Rig up.....

Drilling and Remarks:

clean

RECORD

Cased..... in., ft.

Sand.....

Gas.....

Oil.....

Total Depth.....

PRODUCTION

1st 24 hrs. Nat.....

1st 24 hrs. after shot.....

Gas..... Cu. Ft.

Dry Hole.....

Abandoned.....

Date

3-7-34 192

O. Mannes Scout

Map No. 72 Sec. 21 Twp. 13 R. 14W

Well No. 1-Barrell

Tom palmed Company

Contractor

COMPLETED

SECTION PLAT

			0

330 Ft. from N. Line

_____ Ft. from S. Line

330 Ft. from E. Line

_____ Ft. from W. Line

Location _____

Rig up _____

Drilling and Remarks:

692 lbs
oil

RECORD

Cased _____ in., _____ ft.

Sand siliceous 3278'

Gas _____

Oil _____

Total Depth 3281

PRODUCTION

1st 24 hrs. Nat. _____

1st 24 hrs. after shot _____

Gas _____ Cu. Ft.

Dry Hole _____

Abandoned _____

ORVAL MANNSCHECK

Date

6-27-37 19

Scout