


Section 10 Township 15 Range 11W
Well No. 6 Boxberger "B"
Company N C R A

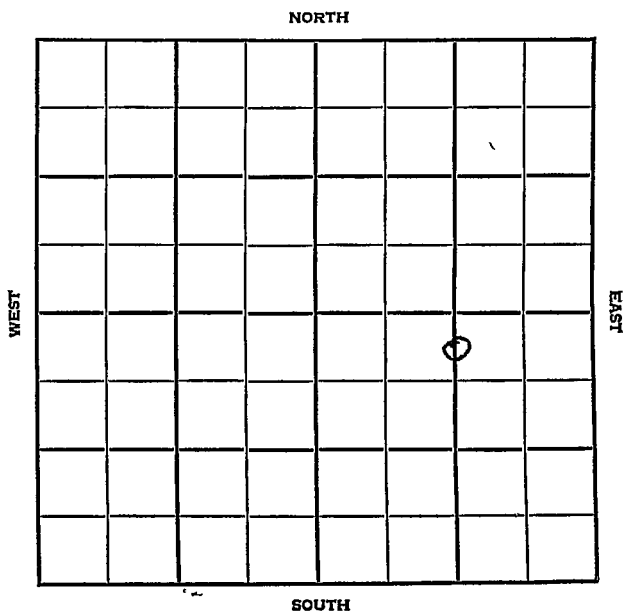

Russell

KANSAS

SEC	TWP	R
10	15	14 W

WELL NO.

6 Boxberger "B"

FARM

COMPANY

N C R A

CONTRACTOR

Isern


Trapp Pool

330 Ft from N Line

Ft from S. Line

1320 Ft. from E Line

Ft. from W Line

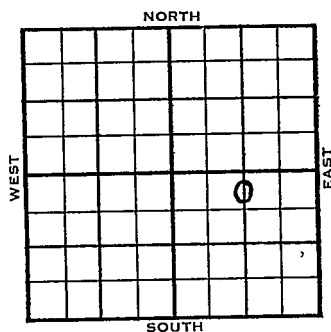C $N\frac{1}{2}$ $N\frac{1}{2}$ SE

	ELEVATION	REPORT
1955	1753'	

3/2 Spud 2-23-55
10" @ 754'
Anhy 750'
Drlg. 2055'

3/30 Spud 2-23-55
Oil Well
TD 3202'
10" @ 754'
Anhy 750' Heeb. 2886' Tor. 2904'
Lans. 2949'
DST 2971'-82' opn 1 hr, rec 560' gas,
100' so & gcm 165#
DST 3032'-67' opn 1 hr, rec 50' gas,
240' so & gcw, 291' wtr 570#
Arb. 3199'
TD 3202'
5" @ 3200'
CO to 3202' FU 2500' fluid 14 hr.
Comp 51 bopd. 9 bw.

COMPLETED

County Russell State KansasSec. 10 (Blk
Twp) 15 (Sur.
Rge) 14W Map No.Operator N C R AWell No. 6 Farm Boxberger "B"Elev. 1753 Location C N $\frac{1}{2}$ N $\frac{1}{2}$ SE

FIRST REPORT

330 Ft. From N Line SE1320 Ft. From E Line Quarter1st. Report MAR 2 1955CompletionRemarksIsern - Contr.Spudding Date 2-23-55Drlg. Data Trapp Pool10" @ 754 Anhy 750 drlg. 2055


FABEN GILSTRAP

County Russell State Kansas
 Sec. 10 (Blk. 15) (Sur. 14W) (Rge) Map No.

Operator N C R A

Well No. 6 Farm Boxberger "B"

Elev. 1753 Location C N $\frac{1}{2}$ N $\frac{1}{2}$ SE

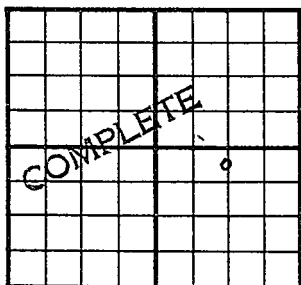

330 Ft. From N Line SE

1320 Ft. From E Line Quarter

Ist. Report

Completion MAR 30 1955

Remarks Trapp Pool

Isern - Contr.

Spudding Date 2-23-55

Drlg. Data Oil well TD 3202

10" @ 754 Anhy 750 Heeb. 2886

Tor. 2904 Lans. 2949 DST 2971-82

open 1 hr. Rec. 560' gas 100' so & gcm

165# DST 3032-67 open 1 hr. Rec. 50'

gas 240' so & gcw 291' wtr. 570#

Arb. 3199 TD 3202 5" @ 3200 CO to

3202 FU 2500' fluid 14 hr.

Comp. 51 hopd 9 bw

FABEN GILSTRAP