


DX 78-1 Barton

KANSAS

Section 20 Township 16S Range 12W

Well No. #1 Christians

Company K & E Drlg et al

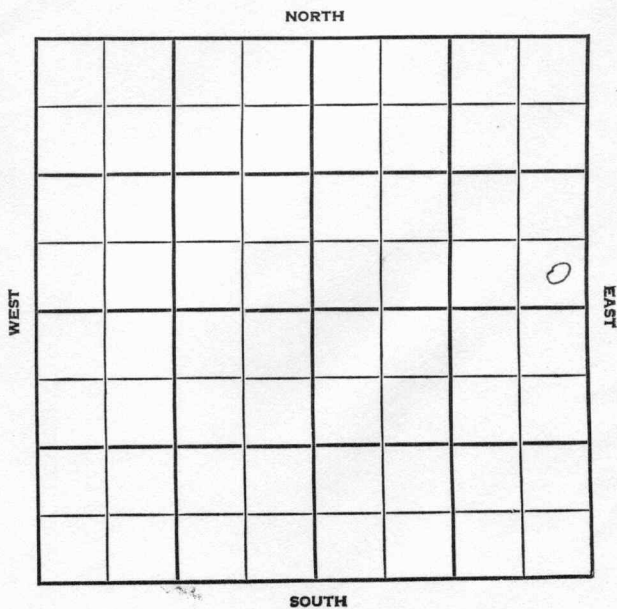

Barton

KANSAS

SEC.	TWP.	R.
20	16	12W

WELL NO.

#1 Christians

FARM

COMPANY

K & E Drlg. etal

CONTRACTOR

K & E

Beaver So.


FT. FROM N. LINE

FT. FROM S. LINE

FT. FROM E. LINE

FT. FROM W. LINE

SE SE NE

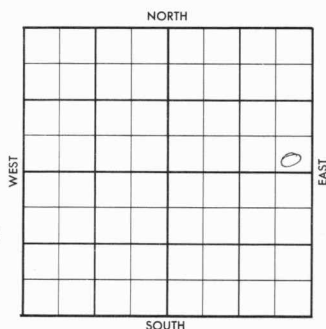

1956	ELEVATION	REPORT
	1924'	

8-1

Comm. 7-30-56
8" @ 350 w/175
WOC

8-22

DST 3109-70 op 30 min. rec. 60' mud,
BHP 810/20".
DST 3396-3402 op 30 min. rec. 10' mud,
BHP 825/20".
D & A
H. 3018'; Tr. 3035'; Dg. 3045';
BL. 3104'; L. 3121'; C. 3360';
A. 3394';
TD 3420'

ABANDONED

County Barton

Elev. _____

Sec. 20Twp. 16SRge. 12WCompany K & E Drilg. etalFarm Name ChristiansNo. 1

Co.

Lse.

No.

Sec.

T.

R.

TOPS

DEPTH

LOG

DATUM

Loc. in Sec. _____

Anh. _____ SE SE NE

Tp. _____

H. _____

Tr. _____

Dg. _____

Bl. _____

L. _____

K.C. _____

B.K.C. _____

Ce. _____

C. _____

M. _____

M. _____

K. _____

Mz. _____

Me. _____

V. _____

S. _____

S. _____

A. _____

R. _____

Pe. _____

G. _____

T.D. _____


Geol. _____

Contr. _____

K & E

Pool _____

Beaver So.

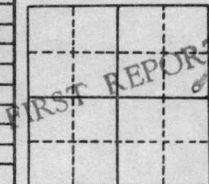Date Comm. 7-30-56

AUG 1 1956

8" 350 w/175 sx; WOC

8201

T DUA

G.R.

CORRECTION

FORM 513 SUNRAY

County Barton Elev. 1924
 Sec. 20 Twp. 16S Rge. 12W
 Company K & E Drilg. etal
 FarmName Christians No. X 2

TOPS	DEPTH	LOG	DATUM	Loc. in Sec.
Anh.				SE SE NE
Tr.				
H.	3018			
Tr.	3035			
Dg.	3045			
BL.	3104			
L.	3121			
K.C.				Geol.
B.K.C.				Contr.
Ce.				
C.	3360			K & E
M.				
M.				Pool
K.				Beaver So.
Mz.				
Mo.				
V.				
S.				
S.				
A.	3394			
R.				
Pe.				
G.				
T.D.	3420			

ABANDONED

Date Comm. 7-30-56 AUG 22 1956

8" 350 w/15 SX; WOC AUG 9 '56

DST 3109-70 30" rel 60' Md
 BHP 810 120" DST 3396-3402
 30" rel 10' Md BHP 825/20
 ID 3420

AUG 15 '56

AUG 22 '56

~~1953~~

DCA