


Russell

Form 51-5M-5-34-Palace

Map No. **KANSAS** Sec. 21 Twp. 13 R. 14^W

Well No. 1 Driscoll Farm
ITIO Company

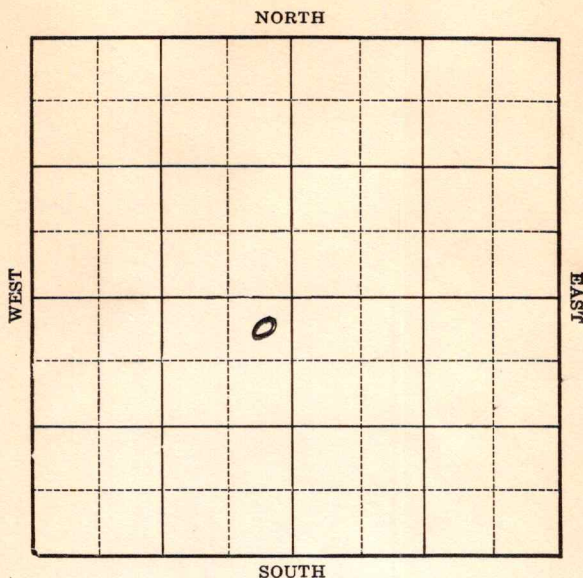

Location _____

Drilling Remarks _____

Rig Up _____

Drilling Remarks _____

RECORD

Cased _____ in. _____ ft.

Sand _____

Gas _____

Oil _____

Total Depth _____

PRODUCTION

1st 24 hrs. Nat. _____

1st 24 hrs. after shot _____

Gas _____ cu. ft.

Dry Hole _____

Abandoned _____

Russell

Map No. KANSAS Sec. 21 Twp. 13 R. 14^W

Well No. 1 Driscoll Farm


L. G. J. O. Company

330 Ft. from N. Line

 Ft. from S. Line

330 Ft. from E. Line

 Ft. from W. Line

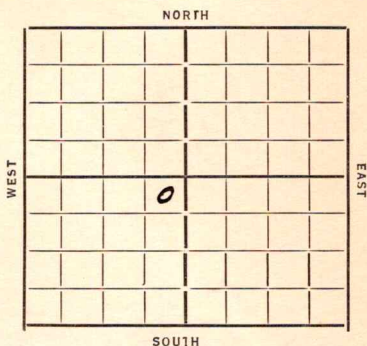

Date

REPORT

7/25	Location
8/2	Pond
8/9	Rig
8/16	Spud
8/23	20" 31 47 1/2 340 15" 360
	Dly 730
8/30	" 1140 18" 866
9/6	" 2075
9/13	" 2475 10" 2462
9/20	" 2880
9/27	" 3334 Lansing 3028
10/3	Silicious 3359 T 7 3383 Dr A

ABANDONED

KANSAS

Map No. 78 Sec. 21 Twp. 13 R. 14WWell No. 1-DriscollITIO

Company

Contractor

FIRST REPORTS

SECTION PLAT

330 Ft. from N. Line

Ft. from S. Line

330 Ft. from E. Line

Ft. from W. Line

Location ✓

Rig up

Drilling and Remarks:

RECORD

Cased _____ in., _____ ft.

Sand _____

Gas _____

Oil _____

Total Depth _____

PRODUCTION

1st 24 hrs. Nat. _____

1st 24 hrs. after shot _____

Gas _____ Cu. Ft.

Dry Hole _____

Abandoned _____

Date

ORVAL MANNSCHRECK

7-25-34 19

Scout

KANSAS

Map No. 72 Sec. 21 Twp. 13 R. 14WWell No. 1- RussellITIO Company

Contractor

ABANDONED

SECTION PLAT

330 Ft. from N. Line

Ft. from S. Line

330 Ft. from E. Line

Ft. from W. Line

	0		

Location

Rig up

Drilling and Remarks:

RECORD

Cased _____ in., _____ ft.

Sand silicious 3359

Gas _____

Oil _____

Total Depth 3383

PRODUCTION

1st 24 hrs. Nat. _____

1st 24 hrs. after shot _____

Gas _____ Cu. Ft.

Dry Hole _____

Abandoned _____

Date

10-3-34 192

ORVAL MANNSCHRECK

Scout