


DX 78-1 Barton

KANSAS

Section 20 Township 16 Range 12W

Well No. #4 Christians

Company Franco Central

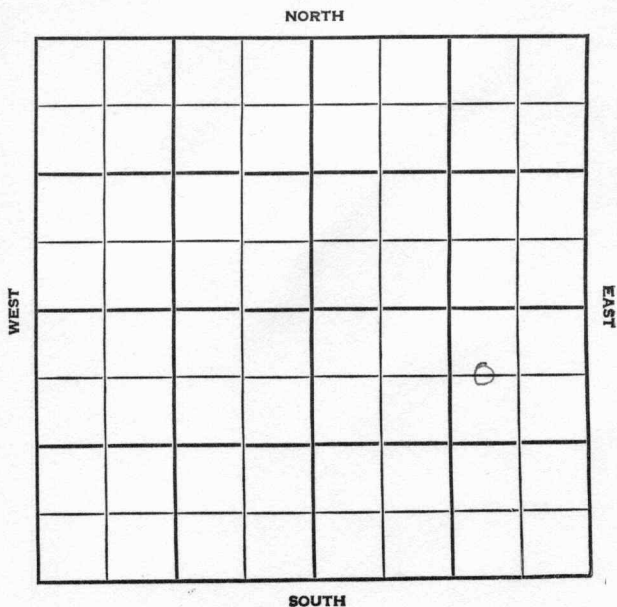

SEC.

20

TWP.

16

R.

12W

Barton

KANSAS

WELL NO.

#4 Christians

FARM

COMPANY

Franco-Central

CONTRACTOR


Lewis-Drlg.

____ FT. FROM N. LINE

____ FT. FROM S. LINE

____ FT. FROM E. LINE

____ FT. FROM W. LINE

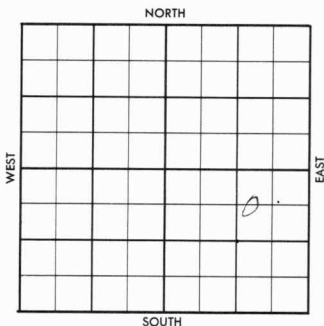C W $\frac{1}{2}$ NE SE

ELEVATION

1956

REPORT

8-22

Comm. 8-18-56
8" @ 373 w/200
Drlg. 1640

County Barton Elev. _____
 Sec. 20 Twp. 16 Rge. 12W
 Company Franco-Central
 Farm Name Christians No. 4

TOPS	DEPTH	LOG	DATUM
Anh.			
TP.			
H.			
Tr.			
Dg.			
BL.			
L.			
K.C.			
B.K.C.			
Ce.			
C.			
M.			
M.			
K.			
Mz.			
Me.			
V.			
S.			
S.			
A.			
R.			
Pe.			
G.			
T.D.			

Loc. in Sec. _____

C W $\frac{1}{2}$ NE SE

Geol. _____

Contr. _____

Lewis Drlg.

Pool _____

FIRST REPORT

Date Comm. 8-18-56

AUG 22 '56

8" @ 373/200 drlg. 1640

AUG 22 '56

County Barton Elev. 1925
 Sec. 20 Twp. 16 Rge. 12W
 Company Franco-Central
 Farm Name Christians No. 4

TOPS	DEPTH	LOG	DATUM	Loc. in Sec.
Anh.				C W $\frac{1}{2}$ NE SE
Tp.				
H.	3016			
Tr.	3032			
Dg.				
Bl.	3101			
L.	3118			Geol.
K.C.				Contr.
B.K.C.				Lewis Drlg.
Ce.				
C.				Pool
M.				
M.				
K.				
Mz.				
Mo.				
V.				
S.				
S.				COMPLETE
A.	3372			
R.				
Pe.				
G.				
TD.	3376			OCT 3 '56

Date Comm. 8-18-56

8" @ 373/200 drlg. 1640 AUG 29 '56

DST 3106-90 30" rec. 35' WM

BHP 245 5 1/2 @ 3372/ SEP 5 '56

CO 3376 & 3/4 Boph nat.

no/w 5 h/w no inc in seq.

SEP 12 '56 3d sq. SEP 19 '56 SEP 26 '56 CO

DD 3388 TD 8 4 1/2 Boph 4

has Pop OCT 3 '56 P. 25 Boph

no wtr.