

Barton

KANSAS

FORM 51

Section 20 Township 16 Range 12W

Well No. #1 Beaver Townsite

Company Franco-Central

NORTH

							0

SOUTH

WEST

EAST

Barton

KANSAS

SEC.	TWP.	R.
20	16	12W ✓

WELL NO.

1 Beaver Townsite

FARM

COMPANY

Franco-Central

CONTRACTOR

S. Beaver Pool

Ft. from N. Line


330

Ft. from S. Line

330

Ft. from E. Line

Ft. from W. Line

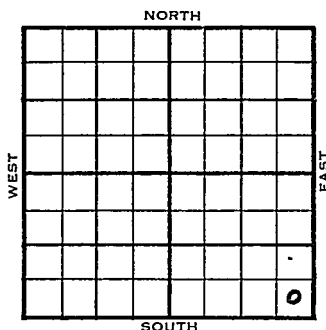


SE SE SE

1953	ELEVATION	REPORT
11/11	Cellar & Pits	
11/18	8" @ 378' w/200 sks Drlg. 2387'	
12/2	Spud 11-11-53 D&A TD 3425' 8" @ 378' Top 2763', Heeb 3003', Tor 3019', B. Oread 3032', Br lime 3091', Lans 3105' B KC 3349', Cong 3350', Arb. 3404' TD 3425' D&A	
ABANDONED		

J. G. McGEHEE

County Barton State Kansas
 Sec. 20 (Blk. 16 (Sur. 12W Map No.
 (Twp.) (Rge.)
 Operator Franco-Central
 Well No. 1 Farm Beaver Townsite
 Elev. 1919 Location SE SE SE

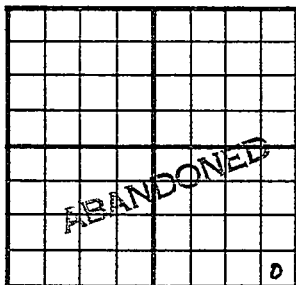

330 Ft. From S Line SE
330 Ft. From E Line Quarter
 1st. Report
 Completion DEC 2 1953
 Remarks S. Beaver Pool

Spudding Date 11-11-53

Drlg. Data D & A TD 3425
8" @ 378 Top. 2763 Heeb. 3003
Tor. 3019 B. Oread 3032 Br. lime 3091
Lens. 3105 B KC 3349 Cong. 3350
Arb. 3404 TD 3425

D & A

J. G. McGEHEE