


Section 10 Township 15 Range 11-W

Well No. #4 Boxberger "B"

Company N C R A

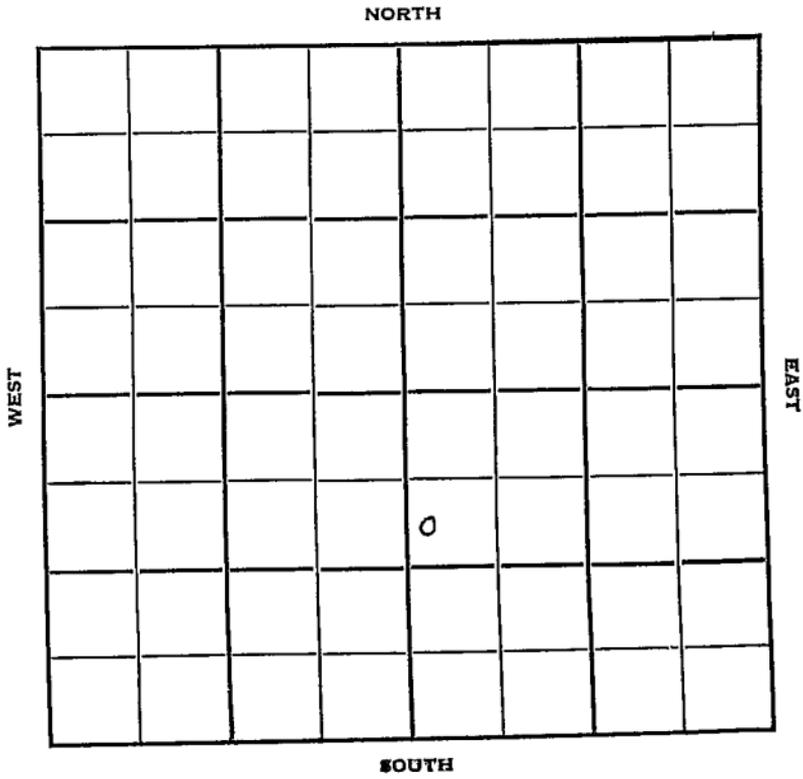

Sec. 10 Twp. 15 R. 14W ✓

Well No. #4 Boxberger "B" Farm

N C R A

Company

Contractor

330' Trapp Pool


990' Ft. from N. Line

Ft. from S. Line

Ft. from E. Line

50' Ft. from W. Line

NW NW SE

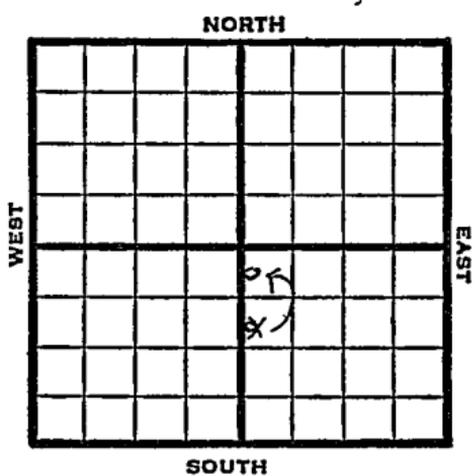

1950 Elev. 1770' REPORT

10/4

8" @ 778'
Drlg. 1950'

11/1

Oil Well TD 3233'
 8" @ 778' Lans. 2969' Arb. 3218-20'
 5" @ 3219' TD 3233'
 B/2 1/4 BO 8 hr. 500 A
 B/8 1/2 GOPH S/32 BO 8 hr.
 500 A S/69 BO 6 hr.
 Comp. 150 BOPD

COMPLETED

County Russell State Kansas

Sec. 10 (Blk. Twp) 15 (Sur. Rge.) 14W Map No.

Operator N C R A

Well No. 4 Farm Boxberger "B"

Elev. 1770 Location

990 Ft. From N Line SE

50 Ft. From W Line Quarter

1st. Report OCT 4 1950

Completion

Remarks

Spudding Date

Drlg. Data Trapp Pool

8" @ 778. drlg. 1950


County Russell State Kansas

Sec. 10 (Blk Twp) 15 (Sur. Rge.) 14W Map No.

Operator N C R A

Well No. 4 Farm Boxberger "B"

Elev. 1770 Location NW NW SE

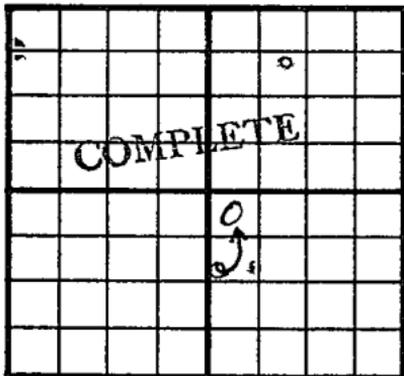

330 Ft. From N Line SE

50 Ft. From W Line Quarter

1st. Report

Completion NOV 1 1950

Remarks Trapp Pool

Spudding Date

Drlg. Data Oil well TD 3233

8" @ 778 Lans. 2969 Arb. 3218-20

5" @ 3219. TD. 3233. B/ 2 1/2 bo 8 hr.

500 A B/ 8 1/2 goph S/ 32 bo 8 hr.

500 A S/ 69 bo 6 hr.

Comp. 150 bopd

*Corrected
from where
JTB*