
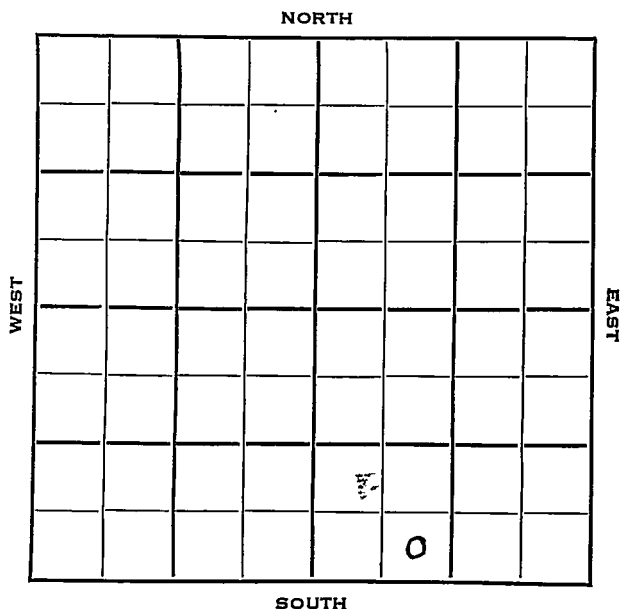


Section 20 Township 16 Range 12WWell No. #1 ChristiansCompany Franco-Central Oil

County **Barton** State **Kansas**
 Sec. **20** (Blk.) **16** (Sur.) **12W** Map No.
 Operator **Franco-Central Oil**
 Well No. **1** Farm **Christians**
 Elev. Location **SE SW SE**

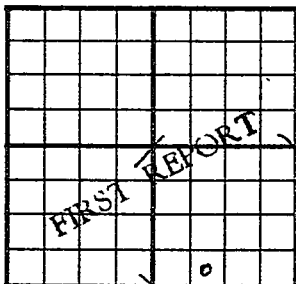

340 Ft. From **S** Line **SE**
990 Ft. From **W** Line Quarter

1st. Report **MAY 6 1953**

Completion

Remarks

Glenn Nye - Contr.


Spudding Date **5-5-53**

Drig. Data

Laudick Pool

J. G. McGEHEE

County Barton State Kansas
 Sec. 20 (Blk. 16 (Sur. 12W Map No.
 (Twp.) (Rge.)
 Operator Franco-Central Oil
 Well No. 1 Farm Christians
 Elev. 1921 Location SE SW SE

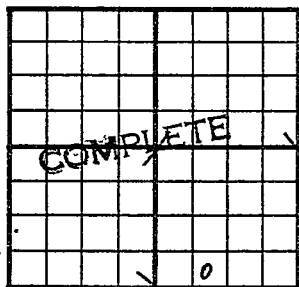

340 Ft. From S Line SE
990 Ft. From W Line Quarter
 1st. Report
 Completion JUN 3 1953
 Remarks Laudick Pool
Glenn Nye - Contr.
 Spudding Date 5-5-53

Drig. Data Oil well TD 3394
8" @ 372 Anhy 837 Howard 2702
Top. 2778 Heeb. 3019 Br. lime 3106
Lans. 3121 DST 3108-30 open $\frac{1}{2}$ hr.
Rec. 10' mud 380# B KC 3359
Arb. 3373 TD 3375 5" @ 3374
DD 3394 $\frac{1}{2}$ boph 500 A 1 boph
1000 A $1\frac{1}{2}$ boph 18 hr.
Comp. 35 bopd