


KANSAS

Well No. #3 Christian

Company Franco-Central

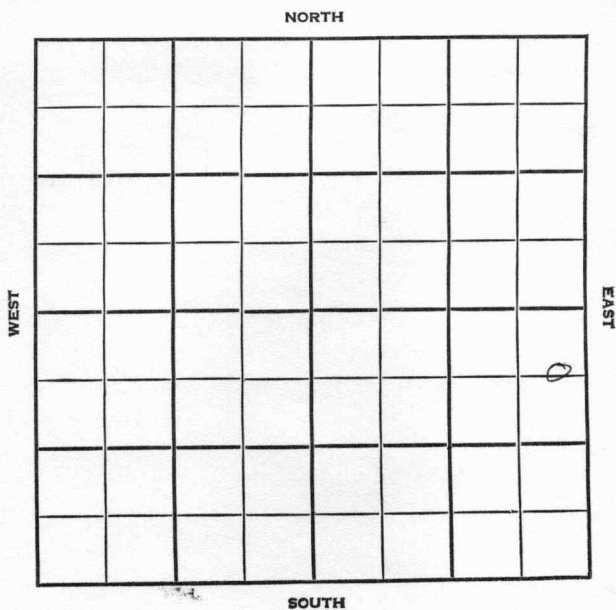

SEC. 20	TWP. 16	R. 12W
------------	------------	-----------

WELL NO.

#3 Christian

FARM

COMPANY

Franco-Central

CONTRACTOR

Lewis tools


S.Beaver

____ FT. FROM N. LINE

____ FT. FROM S. LINE

____ FT. FROM E. LINE

____ FT. FROM W. LINE

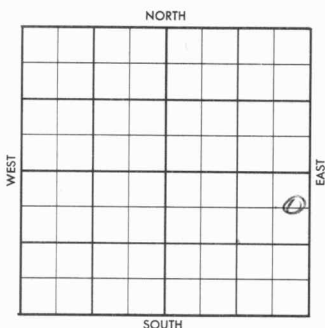C E $\frac{1}{2}$ NE SE

1956

ELEVATION

1924'

REPORT

6-6

MIR

7-18

Comm. 6-5-56

DST 3090-3122 op 60 min. rec. 30' OCM,
60' HOCM, 240' GCO, BHP 1040#5 $\frac{1}{2}$ " @ 3361 w/100

CO

DD 3369

S/ 3 BOPH, no/wtr.,

P/ 25 BOPD, no wtr/

Anh. 835'; Tp. 2762'; H. 3001'/

Tr. 3019'; BL. 3086'; L. 3102';

A. 3359';

TD 336 3'

COMPLETED

County Barton Elev. _____
 Sec. 20 Twp. 16 Rge. 12W
 Company Franco-Central
 FarmName Christian No. 3

TOPS	DEPTH	LOG	DATUM	Loc. in Sec.
Anh.				C E $\frac{1}{2}$ NE SE
TP.				
H.				
Tr.				
Dg.				
BL.				
L.				Geol. _____
K.C.				Contr. _____
B.K.C.				Lewis tools
Ce.				
C.				Pool
M.				S. Beaver
M.				
K.				
Mz.				
Me.				
V.				
S.				
S.				
A.				
R.				
Pe.				
G.				
T.D.				

FIRST REPORT	
JUN 6 '56	6

Date Comm.

M I R

JUN 1 1956

G.R.

County Barton Elev. 1924
 Sec. 20 Twp. 16 Rge. 12W
 Company Franco-Central
 Farm Name Christian No. 3

TOPS	DEPTH	LOG	DATUM	Loc. in Sec.
Anh.	835			C E ¹ / ₂ NE SE
Tr.	2762			
H.	3001			
Tr.	3017			
Dg.				
Bl.	3086			
L.	3102			Geol.
K.C.				Contr.
Ce.				Lewis tools
C.				
M.				Pool
M.				S. Beaver
K.				
Mr.				
Mo.				
V.				
S.				
S.				
A.	3359			
R.				
Pe.				
G.				
TD	3363			

COMPLETE			
JUL	18	1956	
			0

Date Comm.

M I R JUN 13 '56

16-5-56 8"

DST 3090-3122 (60) run 30' OCM
 60' HOCM 240' GCO BHP 1000
 (151) 3145 JUN 20 '56 5 1/2 @ 3361 1100
 co DD 3369 TD (1/2) 3 Bopk
 nolw POP JUN 27 '56 JUL 3 '56 JUL 11 '56
 JUL 18 '56 P. 25 Bopd nolw