


Section 5 Township 15 Range 11 W

Well No. #5 Mitchell

Company Kessler & Schmidt

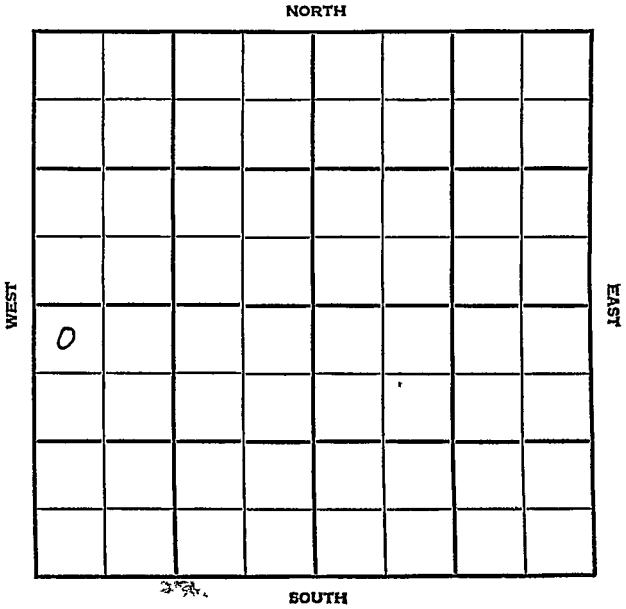

County Russell Elev. \_\_\_\_\_  
 Sec. 5 Twp. 15 Rge. 14W  
 Company Kessler & Schmidt  
 Farm Name Mitchell No. 5

TOPS	DEPTH	LOG	DATUM
Anh.			
TP.			
H.			
Tr.			
Dg.			
BL.			
L.			
K.C.			
B.K.C.			
Ce.			
C.			
M.			
M.			
K.			
Mz.			
Me.			
V.			
S.			
S.			
A.			
R.			
PE.			
G.			
T.P.			

Loc. in Sec. \_\_\_\_\_  
 NW NW SW  
 150' SE #1  
 Geol. \_\_\_\_\_  
 Contr. \_\_\_\_\_  
 Dukes  
 Pool \_\_\_\_\_  
 Gorham

FIRST REPORT  
 OCT 12 1955

Date Comm. 10-10-55

*[Handwritten signature]*

Co.  
Lse.  
No.  
Sec.  
T.  
R.

County Russell Elev. 1806  
 Sec. 5 Twp. 15 Rge. 14W  
 Company Kessler & Schmidt  
 Farm Name Mitchell No. 5

Co.  
Lse.  
No.  
Sec.  
T.  
R.

TOPS	DEPTH	LOG	DATUM
Anh.	837		
TP.			
H.	2943		1137
Tr.	2960		1154
Dg.			
Bl.			
L.	3004		1198
K.C.			
B.K.C.			
Ce.			
C.			
M.			
M.			
K.			
Mz.			
Me.			
V.			
S.			
S.			
A.	3243		1437
R.			
PE.			
G.			
T.D.	3244		

Loc. in Sec. NW NW SW  
 Geol. \_\_\_\_\_  
 Contr. \_\_\_\_\_  
Dukes  
 Pool \_\_\_\_\_  
Gorham

<b>COMPLETED</b>			
------------------	--	--	--

Date Comm. 10-10-55 DEC 7 1955

8 5/8" @ 267 5 1/2" @ 3263/125 CO to  
321 1/4 B/ 3 bohp P/ 7 bopd 48 bw  
P/ 7 bope 60 bw DD 3245 wtr.  
16/ 3077-81 12/ 3008-11 2500 A  
S/ 6 goph S/ wtr. CO to 3244  
2500 A Comp. 7 bopd 150 bw

Russell

KANSAS

SEC	5	TWP	15	R.	14W
-----	---	-----	----	----	-----

WELL NO

#5 Mitchell

FARM

COMPANY

Kessler &amp; Schmidt

CONTRACTOR

Dukes

Gorham

\_\_\_\_\_ Ft. from N. Line


\_\_\_\_\_ Ft from S. Line

\_\_\_\_\_ Ft. from E. Line

\_\_\_\_\_ Ft from W. Line

NW NW SW

150' SE #1

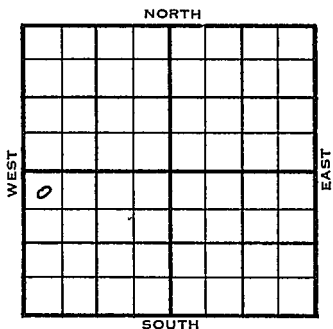

1955

ELEVATION

1806

REPORT

10/12

Comm 10-10-55

12-7

8 5/8" @ 267

5 1/2" @ 3263/125

CO to 3244

B/ 3 boph

P/ 7 bopd 48 bw,

P/ 7 bopd, 60bw,

DD 3245 wtr.

16/ 3077-81, 12/ 3008-11, 2500 A

S/ 6 goph

S/ wtr.,

CO to 3244, 2500 A,

Comp. 7 bopd, 150 bw

Anh. '837

H. '2943'

Tr. '2960

L. 3004

A. 3243

TD 3244

COMPLETED