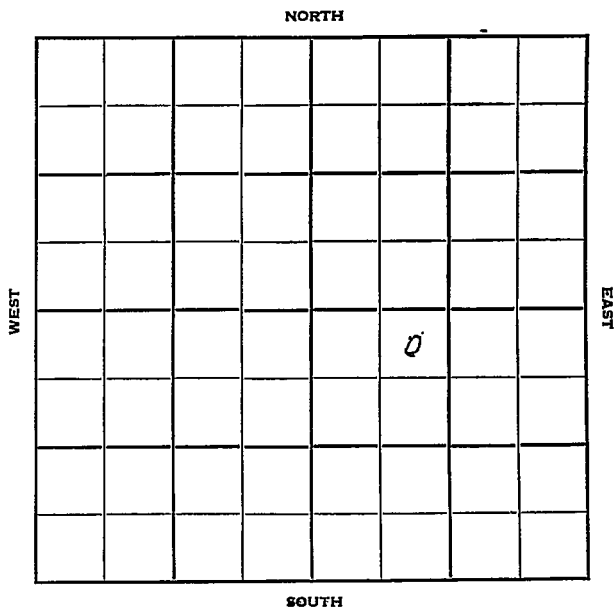


Section 21 Township 16 Range 12WWell No. #1 StoskopfCompany Peel-Hardman

Barton **KANSAS**

Sec. 21 Twp. 16 R. 12W ✓

Well No. #1 Stoskopf Farm

Peel-Hardman Company

Peel - Contr. Contractor


330' Ft. from N. Line

 Ft. from S. Line

 Ft. from E. Line

990' Ft. from W. Line

NE NW SE

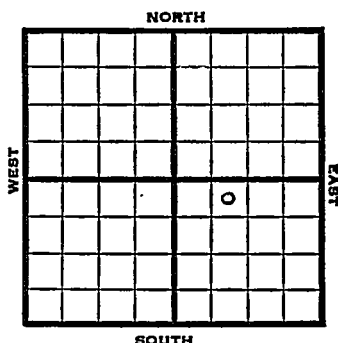

1951 Elev. 1922' REPORT

4/11 Spud 4-8-51
8" @ 304'
WOC

5/2 Spud 4-8-51 D & A TD 3450'
8" @ 304 Heeb 3017' Lans 3123'
Cong 3398' Arb. 3424'
DST 3289-3307' open 45 min. rec 13'
mud TD 3450'
D & A

ABANDONED

County **Barton** State **Kansas**Sec. **21** (Blk. Twp.) **16** (Sur. Rge.) **12W** Map No.Operator **Peel - Hardman**Well No. **1** Farm **Stoskopf**Elev. **1922** Location **NE NW SE**

330 Ft. From **N** Line **SE****990** Ft. From **W** Line **Quarter**1st. Report **APR 11 1951**

Completion

Remarks

Peel - Contr.Spudding Date **4-8-51**

Drlg. Data

8" @ 304 WOC**J. E. TYRA**

J. E. TYRA