


Section 21 Township 16 Range 12-W

Well No. #1 Stoskopf

Company Bay Pet.

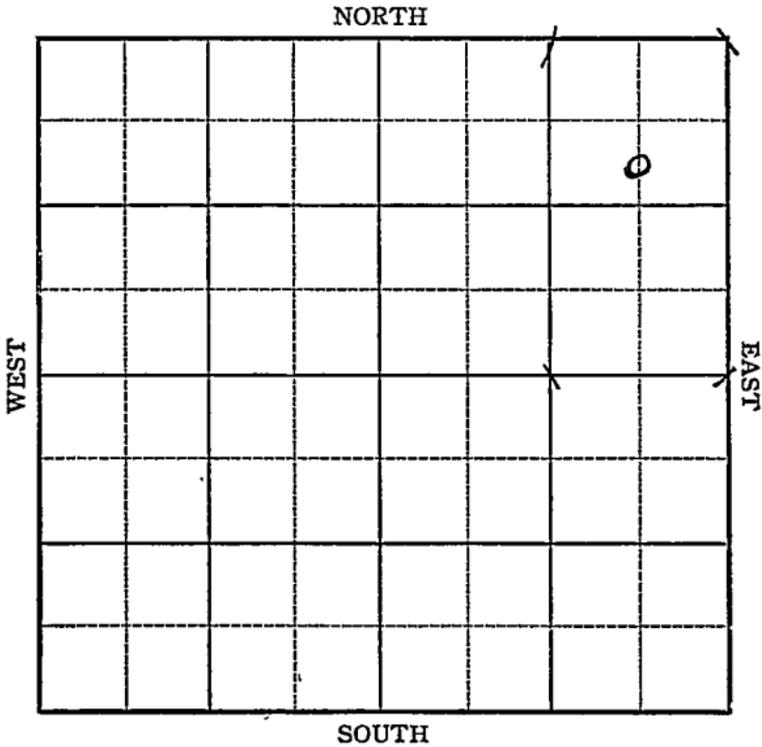

KANONIA

Barton

Sec. 21 Twp. 16 R. 12-W

Well No. #1 Stoskopf Farm


Bay Petroleum Company

990 Ft. from N. Line

_____ Ft. from S. Line

660 Ft. from E. Line

_____ Ft. from W. Line

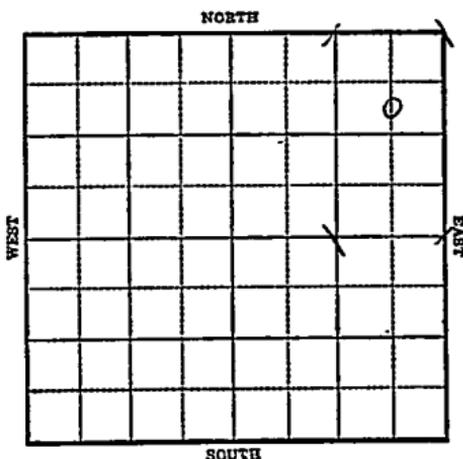

1943

R E P O R T

10/13

8" @ 312'
820'

10/20

Anhy 805
Topeka 2691
Drlg. 2771

10/27

Topeka 2778 Corrected
Lans 3103
BKC 3365
Sovy 3370
Arb 3393
Drlg. 3430

11/3

Arb 3393
No shows
T.D. 3433'

ABANDONED

Barton

Map No. 39 **KANSAS** Sec. 21 Twp. 16 R. 12W

Well No. 1 Stoskopf

Bay Petroleum Company

FIRST REPORT Contractor

C S L N E N E

SECTION PLAT

990 Ft. from N. Line

_____ Ft. from S. Line

660 Ft. from E. Line

_____ Ft. from W. Line

Beaver Pool

Location _____

Rig up _____

Drilling and Remarks:

8"-312 820'

Darby farm-out

RECORD

Cased _____ in., _____ ft.

Sand _____

Gas _____

Oil _____

Total Depth _____

PRODUCTION

1st 24 hrs. Nat. _____

1st 24 hrs. after shot _____

Gas _____ Cu. Ft.

Dry Hole _____

Abandoned _____

Date

OCT 13 1943

19

S. J. LEWIS Scout

Map No. **KANSAS** Sec. 21 Twp. 16 R. 12W

Well No. 1 Stoskopf

Bay Petroleum Company

ABANDONED Contractor

C S L M E NE

SECTION PLAT

990 Ft. from N. Line

_____ Ft. from S. Line

660 Ft. from E. Line

_____ Ft. from W. Line

Beaver Pool

Location _____

Rig up _____

Drilling and Remarks:

See # 3293
Noshovos

RECORD

Cased _____ in., _____ ft.

Sand _____

Gas _____

Oil _____

Total Depth 3433

PRODUCTION

1st 24 hrs. Nat. _____

1st 24 hrs. after shot _____

Gas _____ Cu. Ft.

Dry Hole _____

Abandoned _____

Date

NOV 3 1943

S. J. LEWIS Scout