

KANSAS

FORM 51 5M 10-41 PETROL


Russell

Section 10 Township 15 Range 14-W

Well No. #1 Fegler

Company Pryor & Lockhart etal

Trapp Pool

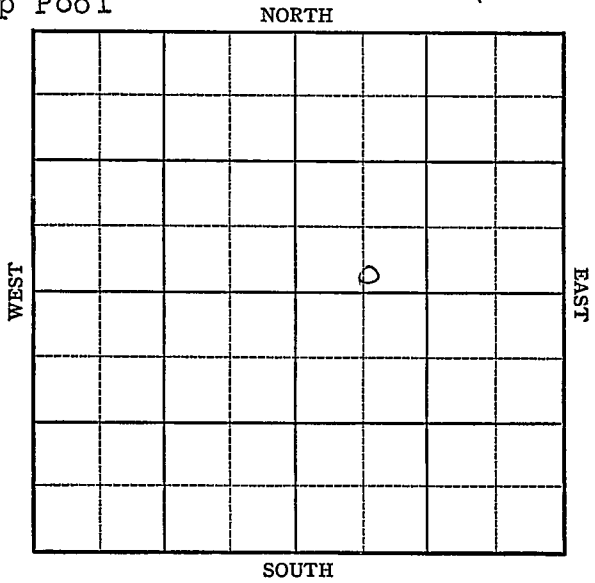

Sec. 10 Twp. 15 R. 14-W

Well No. #1 Fegler Farm

Pryor & Lockhart et al Company

(Trapp Pool)


_____ Ft. from N. Line

330 Ft. from S. Line

_____ Ft. from E. Line

660 Ft. from W. Line

Elv. 1761

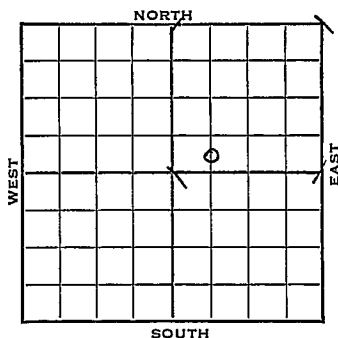

1942	REPORT
9/16	Cable (Stanolind Farmout)
9/23	15" 51' T.D. 308'
9/30	Drlg. 1540'
10/7	Drlg. 2200
10/14	Drlg. 2365' 8" @ 2346'
10/21	8" @ 2495 Topeka 2690 Dodge 2938 Drlg 3000'
10/28	Arp 3241 Pay 3251-55 TD 645' oil in 10 hrs Sdown for 5" csq csq.
11/4	5" @ 3243 WOC
11/11	" "
11/18	" "
11/24	Arb. 3241 5" @ 3243' T.D. 3255' Pump 164 Pot. Gravity 39

COMPLETED

Russell

KANSAS

Map No. 73 Sec. 10 Twp. 15 R. 14WWell No. 1 HeglerPryor & Lockhart et al. Company**COMPLETED**

Contractor

C SL SW NE

SECTION PLAT

 Ft. from N. Line330 Ft. from S. Line Ft. from E. Line660 Ft. from W. Line

TRAP POOL

Location Rig up

Drilling and Remarks:

*Cr 43241**5" 3243**Pump 1640 ft.**39° Gr*

RECORD

Cased in., ft.Sand Gas Oil Total Depth 3255

PRODUCTION

1st 24 hrs. Nat. 1st 24 hrs. after shot Gas Cu. Ft.Dry Hole Abandoned

Date

NOV 24 1942 19

S. J. LEWIS Scout