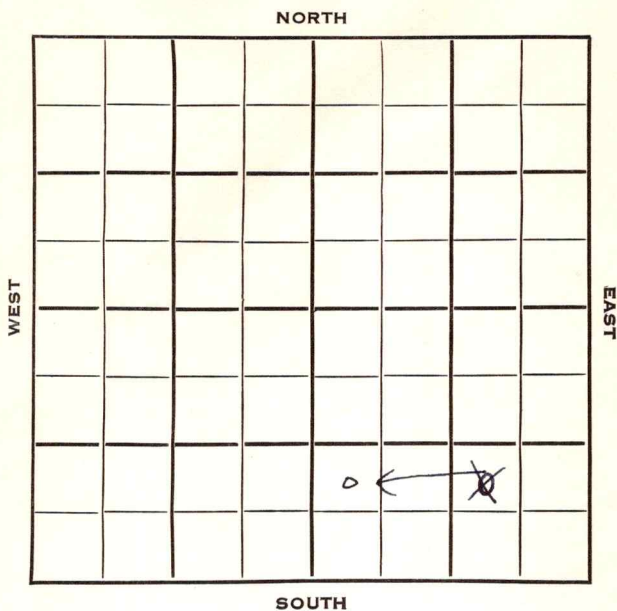


Section 22 Township 13 Range 14 WWell No. # 1 BenderCompany Stearns Drlg.


Russell

KANSAS

Sec. 22 Twp. 13 R. 1/WWell No. #1 Bender FarmStearns Drig. Company

Contractor

Ft. from N. Line

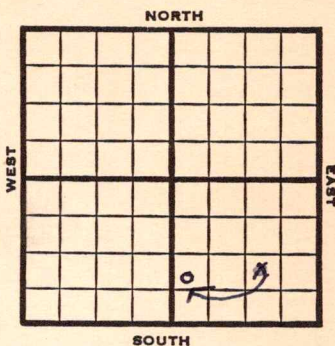~~990~~ ⁸⁸⁰ Ft. from S. Line~~990~~ Ft. from E. Line200 Ft. from W. LineNW ~~SE~~ SE
SW

1953

Elev. 1843' REPORT

6/3

Spud 5-27-53
8" @ 223'
Drlg 2430'

6/10

N.R.

6/24

D & A

7/1

Spud 5-27-53 D & A TD 3301
 8" @ 223 Top. 2712 Heeb 2940
 Levenworth 2944 Tor. 2959 Doug 2978
 Lans 2998 Cong 3271 TD 3301
 D & A

ABANDONED

2

or


[illegible]

990 Ft. From S Line SE

990 Ft. From E Line Quarter

1st. Report JUN 3 1953

Completion

Remarks

Spudding Date 5-27-53

Drlg. Data

8" @ 223 drlg. 2430

J. G. McGEHEE

Kansas

Map No. _____ Sec. 22 Twp. 13 R. 14WWell No. 1 Bender

Stearns Drlg. _____ Company

CORRECTION

Contractor

NW SW SE

SECTION PLAT

		0	

_____ Ft. from N. Line

880 Ft. from S. Line

_____ Ft. from E. Line

200 Ft. from W. Line

Russell County

Location _____

Rig up _____

Drilling and Remarks:

Reported

NW SE SE

RECORD

Cased _____ in., _____ ft.

Sand _____

Gas _____

Oil _____

Total Depth _____

PRODUCTION

1st 24 hrs. Nat. _____

1st 24 hrs. after shot _____

Gas _____ Cu. Ft.

Dry Hole _____

Abandoned _____

Date 7

J. G. McGEHEE

JUN 7 0 195 19

Scout

County Russell State KansasSec. 22 (Blk.
Twp.) 13 (Sur.
Rge.) 14 W Map No.Operator Stearns Drlg.Well No. 1 Farm BenderElev. 1843 Location NW SW SE880 Ft. From S Line SE200 Ft. From W Line Quarter1st. ReportCompletion JUL 1 1953RemarksSpudding Date 5-27-53Drlg. Data D & A TD 33018" @ 223 Top. 2712 Heeb. 2940Levenworth 2944 Tor. 2959 Doug. 2978Lens. 2998 Cong. 3271 TD 3301D & A