

Section 22 Township 13 Range 14WWell No. #2 FoxCompany Lewis Mai Pet.

NORTH

							0

WEST

EAST

SOUTH

KANSAS

Russell



Sec. 22 Twp. 13 R. 14-W

Well No. #2 Fox Farm

Lewis Mai Pet Company

B & R Drlg Contractor


 Ft. from N. Line

990 Ft. from S. Line

330 Ft. from E. Line

 Ft. from W. Line

NE SE SE

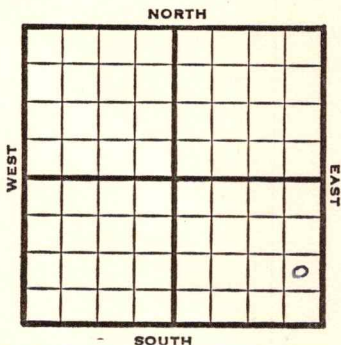

1950

Elev. 1838'

REPORT

12/13

8" @ 180

Drlg 1000'

1951

2/14

Spud 12-8-50

Oil Well TD 3265

8" @ 180' **Anhy 857'**

Top. 2697' **Heeb. 2923'**

Lans. 2981'

DST 3021-31 opn 1 hr

Rec. 55' mud & wtr

DST 3141-56 opn 1 hr Rec. 740'

gco 60' sw

Arb. 3259-61 5" @ 3260'

TD 3265 S/1/2 boph 500 A

S/225 bo 8 hr Comp. 364 bopd.

COMPLETED

County Russell State Kansas
 Sec. 22 (Blk.) 13 (Sur.) 14W Map No.
 Operator Lewis Mai Pet.
 Well No. 2 Farm Fox
 Elev. 1838 Location NE SE SE

COMPLETE									
----------	--	--	--	--	--	--	--	--	--

990 Ft. From S Line SE
 330 Ft. From E Line Quarter

1st. Report

Completion FEB 14 1951

Remarks

B & R Drlg. - Contr.

Spudding Date 12-8-50

Drlg. Data Oil well TD 3265
 8" @ 180 Anhy 857 Top. 2697
 Heeb. 2923 Lans. 2981 DST 3021-31
 open 1 hr. Rec. 55' mud & water DST 3141-
 56 open 1 hr. Rec. 740' gco 60' sw
 Arb. 3259-61 5" @ 3260 TD 3265
 S/ $\frac{1}{2}$ boph 500 A S/ 225 bo 8 hr.
 Comp. 364 bopd

J. E. TYRA