


O. W. P. B.
KANSAS

Section 22 Township 16 Range 12W

Well No. #5 Morgan "B"

Company Vickers Pet.

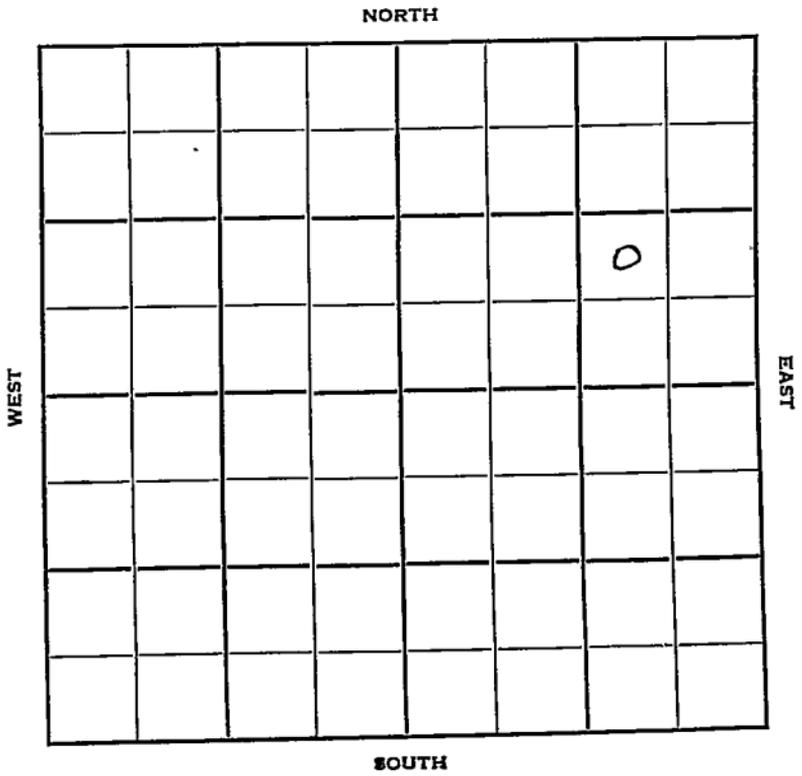

Sec. 22 Twp. 16 R. 12W

Well No. #5 Morgan "B" Farm

Vickers Company

Kraft-Prusa


O. W. P. B.

 Ft. from N. Line

990 Ft. from S. Line

990 Ft. from E. Line

 Ft. from W. Line

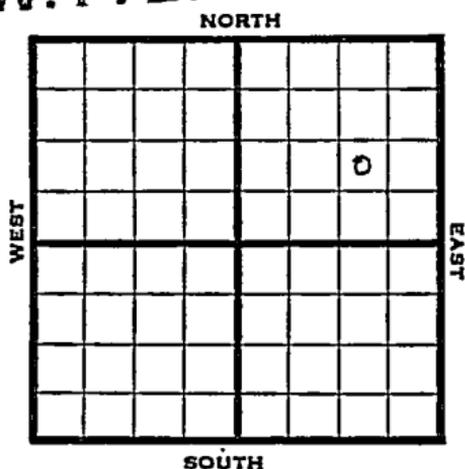

NW SE NE

1948 Elev. 1934' REPORT

4/7 Location

4/14 8" @ 465'
Drlg. 2445'

4/21 Arbuckle 3368'
TD 3370'
5" @ 3369'
RUST

4/28 Arbuckle 3368'
5" @ 3369'
Pump 100 oil Pot.
Gr. 42°
TD 3375'

COMPLETED

1950
4/26

Lans. 3104'
Arb. 3368'
5" @ 3369'
OTD 3375'
DD to 3400 ns
PB 3297'
12/3192-3203
12/3196-3207
1000 acid
Swab 73 BO 10 BW 4 hrs.
PB 3269'
Comp. 351 BOPD

O. W. P. B.

FIRST REPORT
&
COMPLETED

Map No. _____ Sec. 22 Twp. 16 R. 12W

Well No. 5 Morgan "B"

Vickers _____ Company

FIRST REPORT

Contractor _____

NW SE NE

SECTION PLAT

_____ Ft. from N. Line

990 Ft. from S. Line

990 Ft. from E. Line

_____ Ft. from W. Line

			o

Barton County

Location X _____

Rig up _____

Drilling and Remarks:

RECORD

Cased _____ in., _____ ft.

Sand _____

Gas _____

Oil _____

Total Depth _____

PRODUCTION

1st 24 hrs. Nat. _____

1st 24 hrs. after shot _____

Gas _____ Cu. Ft.

Dry Hole _____

Abandoned _____

Date

APR 7 1948 19 S. J. LEWIS Scout

Map No. _____ Sec. 22 Twp. 16 R. 12WWell No. 5 Morgan "B"Vickers Pet._____
Company_____
Contractor

NW SE NE

O. W. P. B.E1. 1934
SECTION PLAT_____
Ft. from N. Line990 Ft. from S. Line990 Ft. from E. Line_____
Ft. from W. Line

		UNT	
			0

Barton County

Location _____

Rig up _____

Drilling and Remarks:

Lans. 3104

Arb. 3368

5" @ 3369

OTD 3375

DD to 3400 ns

PB 3297

RECORD

Cased _____ in., _____ ft.

Sand _____

Gas _____

Oil _____

Total Depth _____

PRODUCTION

1st 24 hrs. Nat. _____

1st 24 hrs. after shot _____

Gas _____ Cu. Ft.

Dry Hole _____

Abandoned _____

Date

APR 26 1930 19J. E. TYRA Scout

12/-3192=3203

12/ 3196-3207

D1000 acid

~~swab 73 bo 10 bw 4 hrs.~~

PB 3269

Comp. 351 bopd

Scout Cards
Land Small Map
Land Wall Map
Tracing
France Map
Pieces Map
Misc.

1956