


Section 22 Township 16 Range 12W

Well No. 3 Morgan "A"

Company Vickers

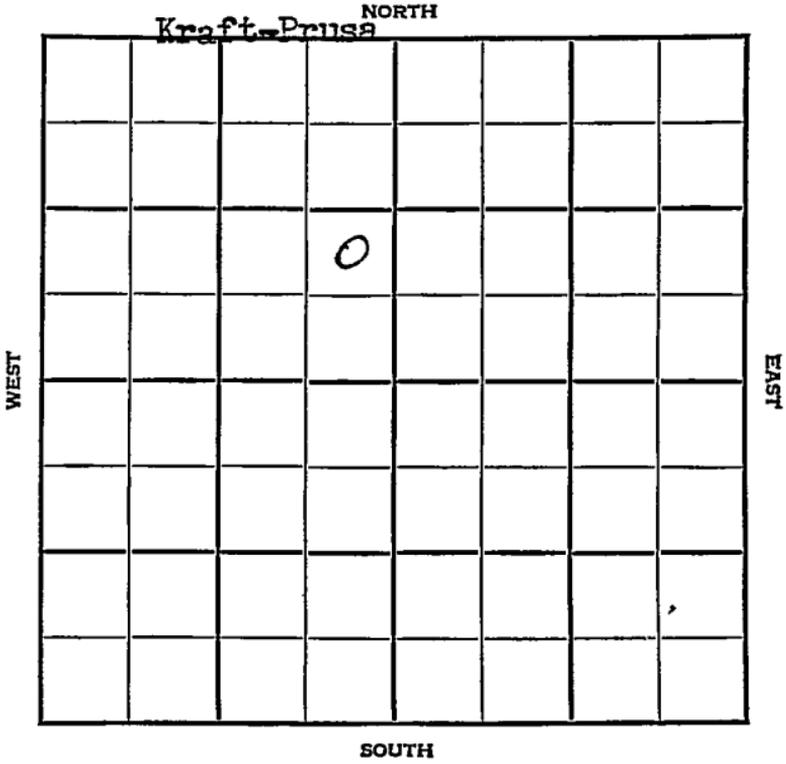

KANSAS

Barton

Sec. 22 Twp. 16 R. 12-W

Well No. #3 Morgan "A" Farm

Vickers Company

Kraft-Prusa Pool


Ft. from N. Line

990' Ft. from S. Line

330' Ft. from E. Line

Ft. from W. Line

NE SE NW

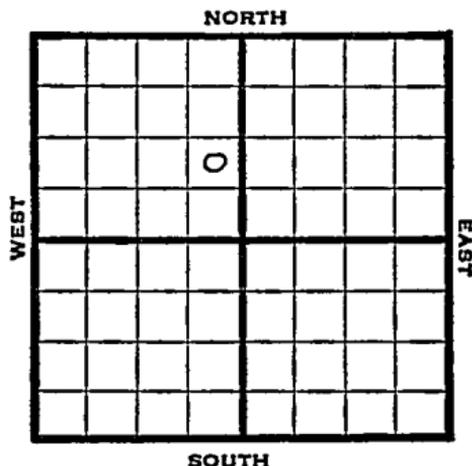

1947	Elev. 1917' REPORT
11/12	RUR
11/19	8" @ 450' Drlg. 2340'
11/25	Brown Lime 3081' Lansing 3102' Arbuckle 3359' TD 3361' 5" @ 3360' RUST
12/3	TD 3369' 500' oil 15 hrs.
12/10	10 qts. no help 1000 acid no help
12/23	Arb. 3359' 5" @ 3360' 1000 acid Pump 20 Pot 42.0 Gr. TD 3369'
COMPLETED	

Map No. _____ Sec. 22 Twp. 16 R. 12W

Well No. 3 Morgan "A"


Vickers Company

FIRST REPORT Contractor

NE SE NW

SECTION PLAT

_____ Ft. from N. Line
990 Ft. from S. Line
330 Ft. from E. Line
_____ Ft. from W. Line

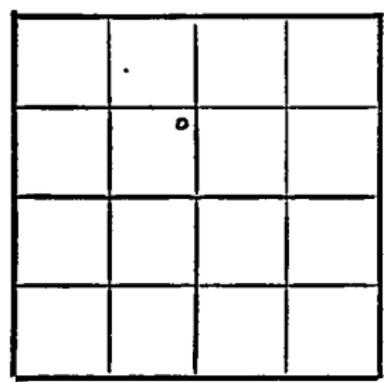

Barton County

Location _____

Rig up _____

Drilling and Remarks: _____

R U R

RECORD

Cased _____ in., _____ ft.
Sand _____
Gas _____
Oil _____
Total Depth _____

PRODUCTION

1st 24 hrs. Nat. _____
1st 24 hrs. after shot _____
Gas _____ Cu. Ft.
Dry Hole _____
Abandoned _____

Date

NOV 12 1947 19

S. J. LEWIS Scout

Map No. 55 Sec. 22 Twp. 16 R. 12W

Well No. 3 Morgan "A"

Vickers Company

COMPLETE

Contractor

NE SE NW

E. 1917
SECTION PLAT

_____ Ft. from N. Line
990 Ft. from S. Line
330 Ft. from E. Line
_____ Ft. from W. Line

		X	
	o		

Barton County

Location _____

Rig up _____

Drilling and Remarks:

See 83359
5" @ 8360
1000 cu ft
June 20 1947
H. J. Lewis

RECORD

Cased _____ in., _____ ft.
Sand _____
Gas _____
Oil _____
Total Depth 826.9

PRODUCTION

1st 24 hrs. Nat. _____
1st 24 hrs. after shot _____
Gas _____ Cu. Ft.
Dry Hole _____
Abandoned _____

Date

DEC 23 1947 19

S. J. LEWIS Scout