


Section 22 Township 16 Range 12W

Well No. #7 Morgan "B"

Company Vickers
Kraft-Prusa

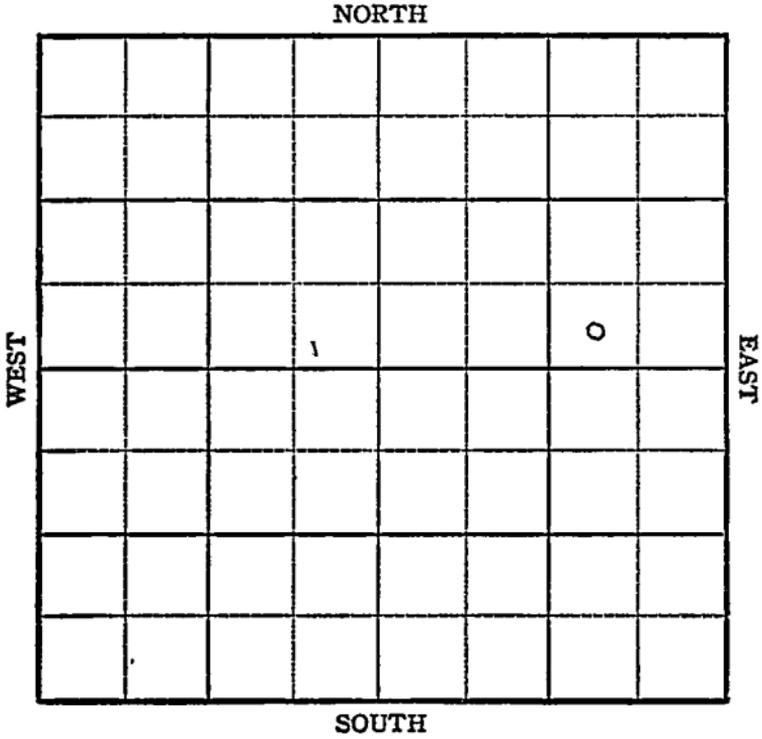

Sec. 22 Twp. 16 R. 12-W

Well No. #7 Morgan "B" Farm

Vickers Company

Kraft-Prusa


 Ft. from N. Line

330 Ft. from S. Line

990 Ft. from E. Line

 Ft. from W. Line

SW SE NE

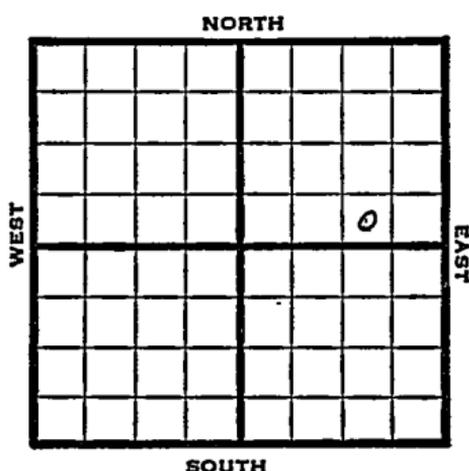

1948	Eli 1934'	REPORT
10/13	8"@ 300'	Drlg 2900'
10/19	Lansing 3113'	Sand 3376'-77'
	5"@ 3376'	TD 3377'
10/26	SLM 3378-75	Arb. 3373
	5"@ 3373	TD 3375 500 acid
11/3	"	
11/10	"	
11/16	"	
11/23	TD 3375'	Arb. 3373'
	5"@ 3373'	500 acid
	Pump 62 Oil Pot	42° Gr.
	Comp	
	COMPLETED	

Map No. _____ Sec. 22 Twp. 16 R. 12W

Well No. 7 Morgan "B"

Vickers Company

FIRST REPORT Contractor

SW SE NE

SECTION PLAT

_____ Ft. from N. Line

330 Ft. from S. Line

990 Ft. from E. Line

_____ Ft. from W. Line

Barton County

RECORD

Location _____

Cased _____ in., _____ ft.

Rig up _____

Sand _____

Drilling and Remarks:

Gas _____

8" @ 300

Oil _____

drlg. 2900

Total Depth _____

PRODUCTION

1st 24 hrs. Nat. _____

1st 24 hrs. after shot _____

Gas _____ Cu. Ft.

Dry Hole _____

Abandoned _____

Date

OCT 13 1948 19

S. J. LEWIS Scout

Map No. 55 Sec. 22 Twp. 16 R. 12W

Well No. 7 Morgan "B"

Vickers Company

COMPLETE

Contractor

SW SE NE

E. 1984

SECTION PLAT

 Ft. from N. Line

330 Ft. from S. Line

990 Ft. from E. Line

 Ft. from W. Line

			0

Barton County

Location

Rig up

Drilling and Remarks:

Co 73223
5" C 3073
580 rods
Pump 620 ft
42° SW

RECORD

Cased in., ft.

Sand

Gas

Oil ✓

Total Depth 3825

PRODUCTION

1st 24 hrs. Nat.

1st 24 hrs. after shot

Gas Cu. Ft.

Dry Hole

Abandoned

Date

NOV 23 19

S. J. LEWIS Scout