

KANSAS

Barton

FORM 51 5M 10-41 PETROL

Section 22 Township 16 Range 12-W

Well No. 1 Penka

Company Bay Petroleum

NORTH Beaver Pool

WEST

EAST

SOUTH

0

KANSAS

Barton

Sec. 22 Twp. 16 R. 12-W

Well No. #1 Penka Farm

Bay Petroleum Company

(Beaver)


_____ Ft. from N. Line

990 Ft. from S. Line

990 Ft. from E. Line

_____ Ft. from W. Line

Elev. 1925

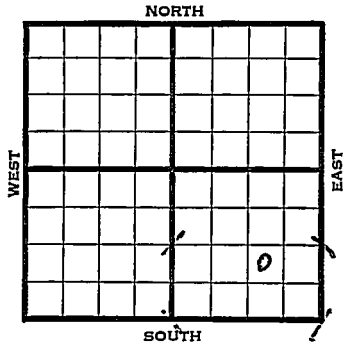

1941

REPORT

12/30

8" - 131'

Drlg. 2541'

1942

1/8

" "

1/14

Arb. 3382'

T.D. 3419'

No shows.

ABANDONED

Map No. 55 Sec. 22 Twp. 16 R. 12WWell No. 1 PenkaBay Petroleum CompanyFIRST REPORT Contractor


NW SE SE

SECTION PLAT

_____ Ft. from N. Line

990 Ft. from S. Line990 Ft. from E. Line

_____ Ft. from W. Line

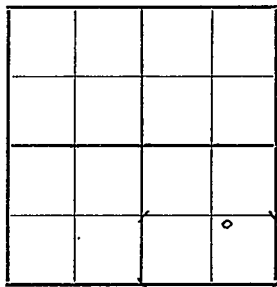BEAVER POOL

Location _____

Rig up _____

Drilling and Remarks:

8" - 131'

Drlg. 2541'

RECORD

Cased _____ in., _____ ft.

Sand _____

Gas _____

Oil _____

Total Depth _____

PRODUCTION

1st 24 hrs. Nat. _____

1st 24 hrs. after shot _____

Gas _____ Cu. Ft.

Dry Hole _____

Abandoned _____

Date

DEC 3 0 1941 19S. J. LEWIS Scout

Barton

KANSAS

Map No. 55 Sec. 22 Twp. 16 R. 12WWell No. 1 PenkaBay Petroleum CompanyABANDONED Contractor

NW SE SE

SECTION PLAT

			o

_____ Ft. from N. Line

990 Ft. from S. Line990 Ft. from E. Line

_____ Ft. from W. Line

BEAVER POOL

Location _____

Rig up _____

Drilling and Remarks:

*Co 83382**No show*

RECORD

Cased _____ in., _____ ft.

Sand _____

Gas _____

Oil _____

Total Depth 3419

PRODUCTION

1st 24 hrs. Nat. _____

1st 24 hrs. after shot _____

Gas _____ Cu. Ft.

Dry Hole _____

Abandoned _____

Date

JAN 1 4 1942 19S. J. LEWIS Scout