


Section 22 Township 16 Range 12W

Well No. #2 Penka "A"

Company Vickers Pet.

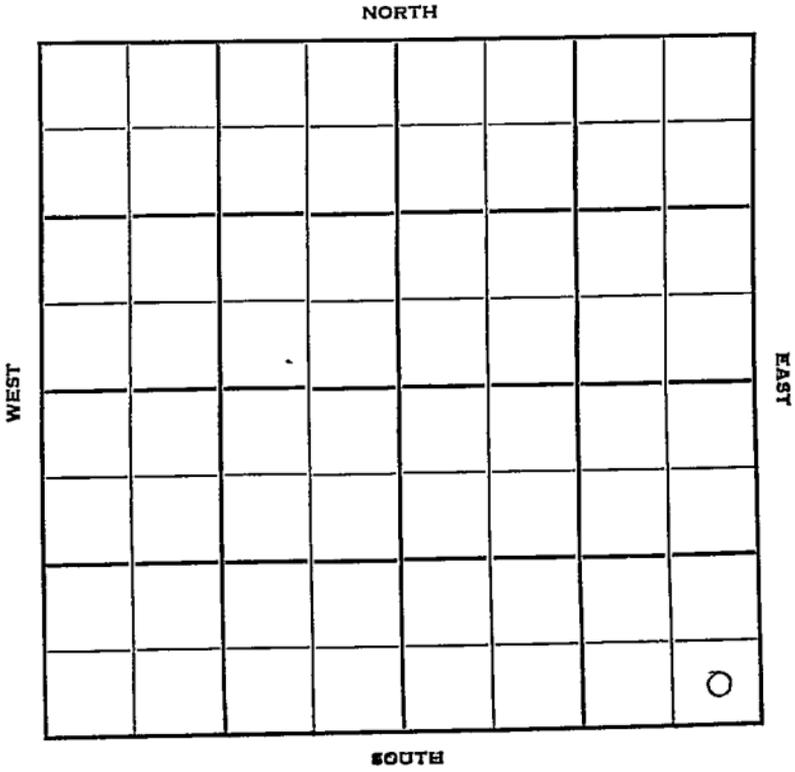

Sec. 22 Twp. 16 R. 12W

Well No. #2 Penka "A" Farm

Vickers Pet. Company

Kraft-Prusa Pool Contractor


 Ft. from N. Line

330' Ft. from S. Line

330' Ft. from E. Line

 Ft. from W. Line

SE SE SE

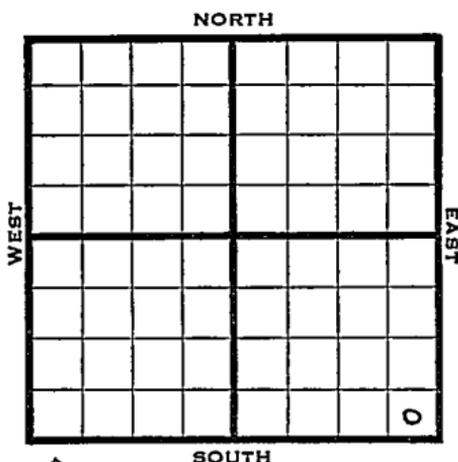

1950

Elev 1920'

REPORT

2/15

RUR

3/22

8" @ 310'

Br Lime 3085'

Lans 3103'

Cong 3369'

Arb. 3377'

TD 3380'

5" @ 3377'

DD 3388 TD

1000 acid

Comp

Fill up 2380' fluid 4 hrs.

Swab 22 BOPH

5% wtr.

Comp 716 BOPH

Comp

COMPLETED

Map No. _____ Sec. 22 Twp. 16 R. 12W

Well No. 2 Penka "A"

Vickers Pet. Company

Contractor

S^E SE SE

SECTION PLAT



_____ Ft. from N. Line

330

_____ Ft. from S. Line

330

_____ Ft. from E. Line

_____ Ft. from W. Line

Barton County

Location _____

Rig up _____

Drilling and Remarks: _____

R U R

RECORD

Cased _____ in., _____ ft.

Sand _____

Gas _____

Oil _____

Total Depth _____

PRODUCTION

1st 24 hrs. Nat. _____

1st 24 hrs. after shot _____

Gas _____ Cu. Ft.

Dry Hole _____

Abandoned _____

Date

FEB 15 1950 19

J. E. TYRA

Scout

Map No. _____ Sec. 22 Twp. 16 R. 12W

Well No. 2 Penka "A"

Wickers Pet. _____ Company

Contractor _____

SE SE SE

E1. 1920
SECTION PLAT


_____ Ft. from N. Line

330 Ft. from S. Line

330 Ft. from E. Line

_____ Ft. from W. Line

Barton County

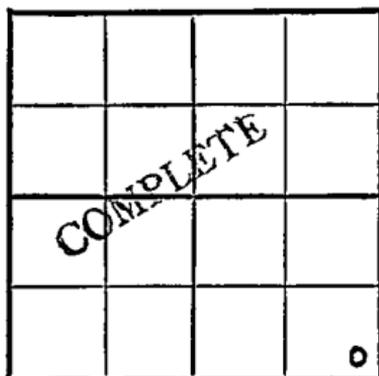

Location _____

Rig up _____

Drilling and Remarks:

8" @ 310

Br. line 3085

Lans. 3103

Cory. 3369

arb. 3377

T.D. 3380

5" C 3377

DD 3388 T.D.

1000 acid

RECORD

Cased _____ in., _____ ft.

Sand _____

Gas _____

Oil _____

Total Depth _____

PRODUCTION

1st 24 hrs. Nat. _____

1st 24 hrs. after shot _____

Gas _____ Cu. Ft.

Dry Hole _____

Abandoned _____

Date

MAR 22 1950

19

J. E. TYRA

Scout

Fill up 2380' fluid 4 hr.


Swab 22 high 5% water

Comp. 716 high

Miss
Pierce Map
France Map
Tracings
Land Wall Map
Land Small Map
Scout Cards

MAR 30 1961

 3
 1
 2
 3
 4
 5
 6
 7
 8
 9
 10
 11
 12

 

1
 2
