

KANSAS

Barton

Section 22 Township 16 Range 12W

Well No. 3 Riemann

Company Bay Pet.

Kraft-Prusa

NORTH

							0

WEST

EAST

SOUTH

Sec. 22 Twp. 16 R. 12W ✓

Well No. #3 Riemann Farm

Bay Pet.

Kraft-Prusa Pool (L.S.T., Cont.) Company


330' Ft. from N. Line

_____ Ft. from S. Line

330' Ft. from E. Line

_____ Ft. from W. Line

NE SE

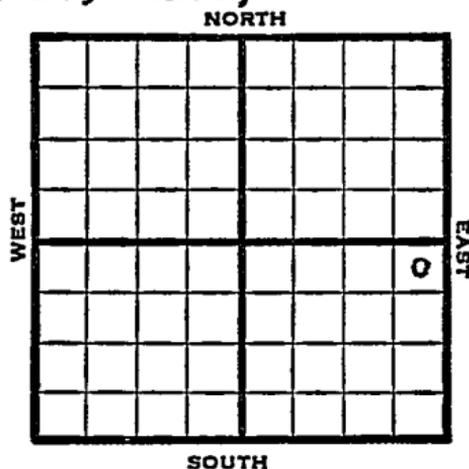

1949

Elev 1928' REPORT

5/25 8" @ 236'
Drlg. 510'
6/1 Drlg 3161'
6/7 Lansing 3108'
Arbuckle 3368'
TD 3370'
5" @ 3368'
6/15 2700' oil 12 hrs.
6/21 500 acid
Swb 24 bbls oil PH
6/28 " "
7/6 " "
7/ 13 TD 3370'
Arb. 3368'
5" @ 3368'
500 acid
Pump 112 oil / 2 % W Pot
420 Gr.
Comp

COMPLETED

Map No. _____ Sec. 22 Twp. 16 R. 12WWell No. 3 Riemann "C"_____
Bay Pet. _____ Company _____

L. S. T.

Contractor _____

NE SE

FIRST REPORT
SECTION PLAT330 Ft. from N. Line_____
Ft. from S. Line330 Ft. from E. Line_____
Ft. from W. Line

			o

Barton County

Location _____

Rig up _____

Drilling and Remarks:

8" @ 236

drlg. 510

RECORD

Cased _____ in., _____ ft.

Sand _____

Gas _____

Oil _____

Total Depth _____

PRODUCTION

1st 24 hrs. Nat. _____

1st 24 hrs. after shot _____

Gas _____ Cu. Ft.

Dry Hole _____

Abandoned _____

Date

MAY 25 1949 19

S. J. LEWIS

Scout

Map No. 455 Sec. 22 Twp. 16 R. 12W

Well No. 3 Riemann

Bay Pet. Company
COMPLETE

Contractor

NE SE

E 1, 1928
SECTION PLAT

330 Ft. from N. Line

_____ Ft. from S. Line

330 Ft. from E. Line

_____ Ft. from W. Line

			o

Barton County

Location _____

Rig up _____

Drilling and Remarks:

Art 3368
5" C 3368
500 ac 1/2
Pump 112 oil + 2 7/8" oil
Pat

42 1/2

RECORD

Cased _____ in., _____ ft.

Sand _____

Gas _____

Oil _____

Total Depth 3370

PRODUCTION

1st 24 hrs. Nat. _____

1st 24 hrs. after shot _____

Gas _____ Cu. Ft.

Dry Hole _____

Abandoned _____

Date

JUL 13 1949 19

S. J. LEWIS Scout