

KANSAS

Barton

Section 22 Township 16 Range 12W

Well No. 4 Riemann

Company Bay Pet.

Kraft-Prusa

NORTH

							0

WEST

EAST

SOUTH

Barton KANSAS



Sec. 22 Twp. 16 R. 12W

Well No. #4 Riemann Farm

Bay Pet.

Kraft-Prusa Pool (L.S.T., Cont.) Company


990' Ft. from N. Line

_____ Ft. from S. Line

330' Ft. from E. Line

_____ Ft. from W. Line

SE NE SE

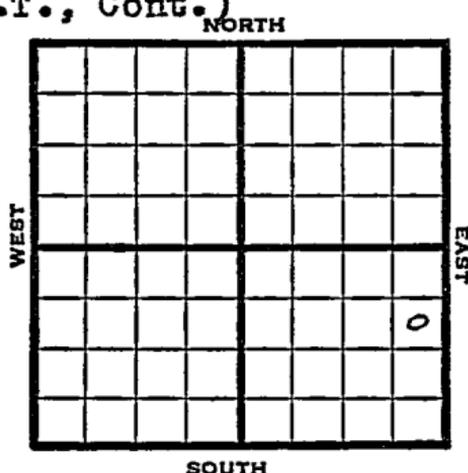

1949 Elev. 1926' REPORT

- 5/25 Location
- 6/1 "
- 6/7 8" @ 257'
- Drlg. 1927'
- 6/15 Lansing 3102'
- Drlg 3280'
- 6/21 Arb. 3358'-63'
- TD 3363'
- 5" @ 3358'
- 6/28 "
- 7/6 "
- 7/12 2
- 7/20 "
- 7/27 Arb 3358'
- 5" @ 3358'
- Pump 91 oil & 30% W Pot.
- Gr. 42°
- TD 3363'

COMPLETED

Map No. _____ Sec. 22 Twp. 16 R. 12W

Well No. 4 Riemann

Bay Pet. _____ Company _____

L. S. T. _____ Contractor _____

SE NE SE

**FIRST REPORT
SECTION PLAT**

990 Ft. from N. Line

_____ Ft. from S. Line

330 Ft. from E. Line

_____ Ft. from W. Line

Barton County

Location X

Rig up _____

Drilling and Remarks:

RECORD

Cased _____ in., _____ ft.

Sand _____

Gas _____

Oil _____

Total Depth _____

PRODUCTION

1st 24 hrs. Nat. _____

1st 24 hrs. after shot _____

Gas _____ Cu. Ft.

Dry Hole _____

Abandoned _____

Date

MAY 25 1949 19

S. J. LEWIS Scout

Kansas

Kraft-Prusa Pool

Map No. K55 Sec. 22 Twp. 16 R. 12WWell No. 4 Riemann

Bay Pet.

Company

COMPLETE

Contractor

SE NE SE

E 1, 1926
SECTION PLAT990 Ft. from N. Line

_____ Ft. from S. Line

330 Ft. from E. Line

_____ Ft. from W. Line

Barton County

Location _____

Rig up _____

Drilling and Remarks:

*CR X3358**5" @ 3358**Pump 9/10 oil + 30% water**Bot.**42 @ 42*

RECORD

Cased _____ in., _____ ft.

Sand _____

Gas _____

Oil _____

Total Depth 926.3

PRODUCTION

1st 24 hrs. Nat. _____

1st 24 hrs. after shot _____

Gas _____ Cu. Ft.

Dry Hole _____

Abandoned _____

Date

JUL 27 1949 19

S. J. LEWIS

Scout