


Section 23 Township 16 Range 12W

Well No. #2 Rieman

Company Carl Todd

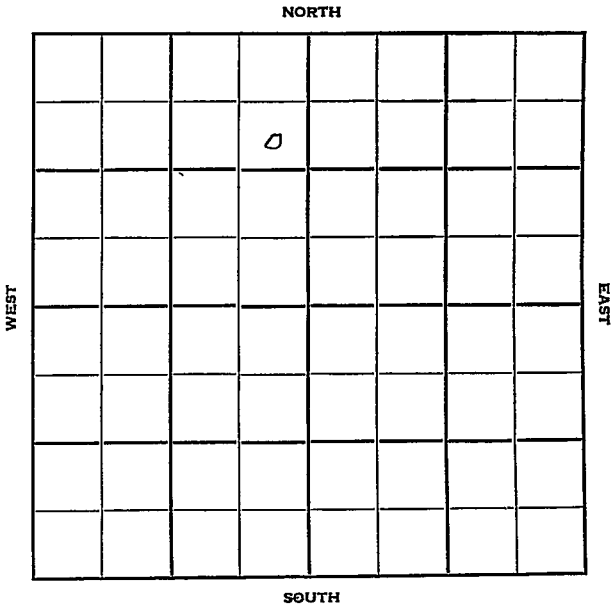

Sec. 23 Twp. \_\_\_\_\_ R. 12W

Well No. #2 Rieman Farm \_\_\_\_\_

Garl Todd Company \_\_\_\_\_

Kraft Prusa Contractor \_\_\_\_\_


990' Ft. from N. Line

\_\_\_\_\_ Ft. from S. Line

330' Ft. from E. Line

\_\_\_\_\_ Ft. from W. Line

SE NE NW

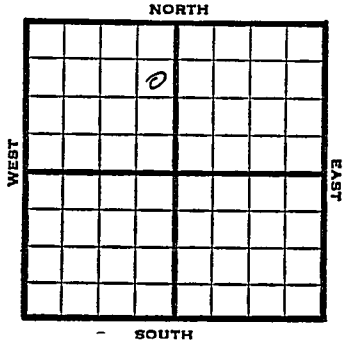

1951 Elev. 1923' REPORT

10/17 Spd 10-10-51  
8" @ 200'  
Drlg. 2550'

12/5 Spud 10-10-51  
Oil Well TD 3369  
8" @ 200  
Top. 2674 Heeb. 2994  
Br. Li 3086 Lans. 3100  
DST 3105-85 open 35 min.  
Rec. 30' mud & SSO TD 3362  
5" @ 3359 GO to 3362  
DD 3364 2 BOPH  
Cong. 3358 DD 3369  
S/ 34 BO 12 hr.  
Comp. 35 BOPD

**COMPLETED**



