

Section 23 Township 16 Range 12 W

Well No. #1 Riemann

Company Carl Todd Drlg.

NORTH

0							

WEST

EAST

SOUTH

Barton

KANSAS ✓

Sec. 23 Twp. 16 R. 12W

Well No. #1 Riemann Farm

Carl Todd Drlg. Company

Todd Drlg. - Contr. Contractor

Kraft-Prusa Pool


990' Ft. from N. Line

_____ Ft. from S. Line

_____ Ft. from E. Line

330' Ft. from W. Line

SW NW NW

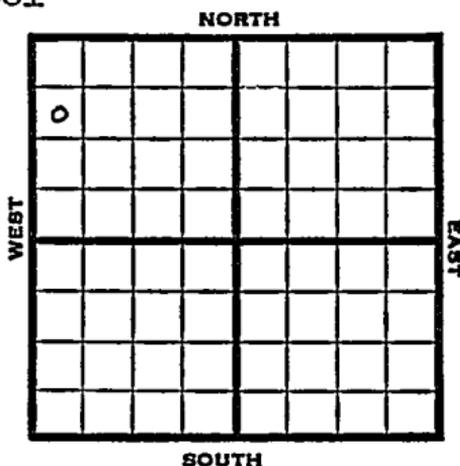

1951 Elev. 1931' REPORT

1/31 RUR
 3/14 Spud 1-30-51
 Oil Well TD 3383
 8" @ 209 Top. 2692
 Heeb. 3010 Br lime 3102
 Lans. 3117 Arb. 3379
 Regan sand 3380-81
 5" @ 3380 TD 3382
 B/1 boph DD 3383 B/2 boph 750 A
 S/97 bf 50% wtr
 Comp. 96 bopd 55% wtr

COMPLETED

County Barton State Kansas

Sec. 23 (^{Blk.}Twp.) 16 (^{Sur.}Rqe.) 12W Map No.

Operator Carl Todd Drlg.

Well No. 1 Farm Riemann

Elev. 1931 Location SW NW NW

0					

COMPLETE

990 Ft. From N Line NW

330 Ft. From W Line Quarter

Ist. Report

Completion MAR 14 1951

Remarks Kraft-Prusa Pool

Todd Drlg. - Contr.

Spudding Date 1-30-51

Drlg. Data Oil well TD 3383

8" @ 209 Top. 2692 Heeb. 3010

Br. lime 3102 Lans. 3117 Arb. 3379

Regan sand 3380-81 5" @ 3380 TD 3382

B/ 1 boph DD 3383 B/ 2 boph 750 A

S/ 97 bf 50% water

Comp. 96 bopd 55% water

J. E. TYRA