


Barton KANSAS

Section 23 Township _____ Range 16 12W

Well No. #7 Reiman

Company W. L. Hartman

NORTH

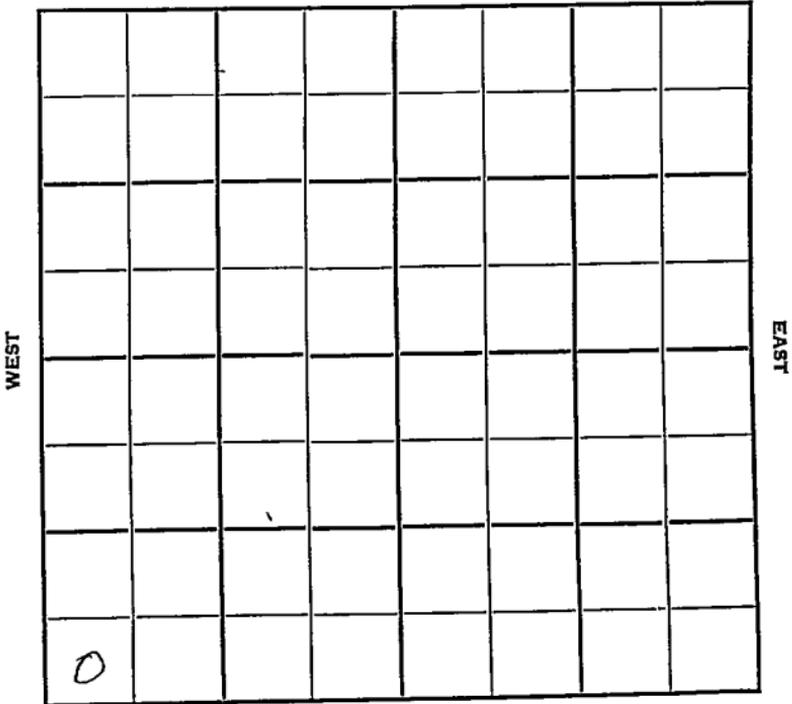

SOUTH

Sec. 23 Twp. R.

Well No. #7 Reiman Farm

W. L. Hartman Company

Contractor
Beaver Pool

Ft. from N. Line

330'


Ft. from S. Line

Ft. from E. Line

330'

Ft. from W. Line

SW SW SW

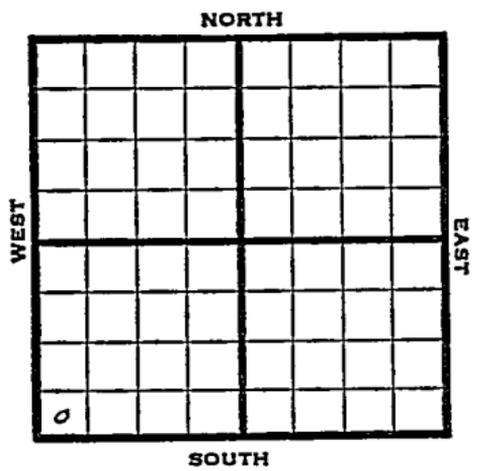

1950

Elev. 1921' REPORT

4/12

Spud 4-7-50
8" @ 165'
Anhy 799-830
Drlg. 2650'

6/7

8" @ 165'
Topeka 2674'
Heeb 2995',
Lans. 3105
Arb. 3358'
5" @ 3358'
Reagan sd 3333'
149 BOPD
TD 3385'

COMPLETED

Kansas

Beaver Pool

Map No. _____ Sec. 23 Twp. 16 R. 12WWell No. 7 Reiman_____ W. I. Hartman _____ Company

_____ Contractor

SW SW SW

E. 1921

SECTION PLAT

_____ Ft. from N. Line

330 Ft. from S. Line

_____ Ft. from E. Line

330 Ft. from W. Line

Barton County

Location _____

Rig up _____

Drilling and Remarks: _____

Spud 4-7-50

8" @ 165

Anhy 799-830

drlg. 2650

RECORD

Cased _____ in., _____ ft.

Sand _____

Gas _____

Oil _____

Total Depth _____

PRODUCTION

1st 24 hrs. Nat. _____

1st 24 hrs. after shot _____

Gas _____ Cu. Ft.

Dry Hole _____

Abandoned _____

Date

APR 12 1950 19J. E. TYRA Scout

Kansas

Map No. _____ Sec. 23 Twp. 16 R. 12W

Well No. 7 Reiman

W. L. Hartman _____ Company

Contractor

SW SW S1

E1.1921

SECTION FLAT

_____ Ft. from N. Line

330 _____ Ft. from S. Line

_____ Ft. from E. Line

330 _____ Ft. from W. Line

COMPLETE			
0			

Barton

Location _____

Rig up _____

Drilling and Remarks:

8" @ 165

Tupaka 2674

Keb 2995

Lans 3105

arb 3358

5" @ 3358

Reagen 5/3333

Date

149BOPD.
JUN 7 1950

19

RECORD

Cased _____ in., _____ ft.

Sand _____

Gas _____

Oil _____

Total Depth 3385

PRODUCTION

1st 24 hrs. Nat: _____

1st 24 hrs. after shot _____

Gas _____ Cu. Ft.

Dry Hole _____

Abandoned _____

J. E. TYRA Scout