


Barton

Section 23 Township 16 Range 12W

Well No. #2 Riemann

Company Shell

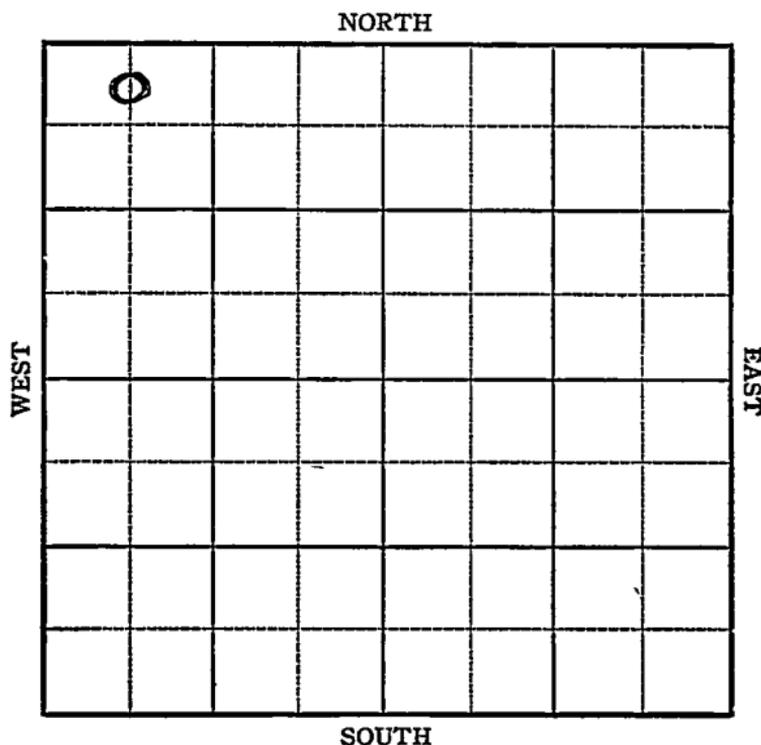

Sec. 23 Twp. 16 R. 12W

Well No. #2 Riemann Farm

Shell Company

Beaver Pool


330 Ft. from N. Line

\_\_\_\_\_ Ft. from S. Line

\_\_\_\_\_ Ft. from E. Line

660 Ft. from W. Line

*Elev. 1929*

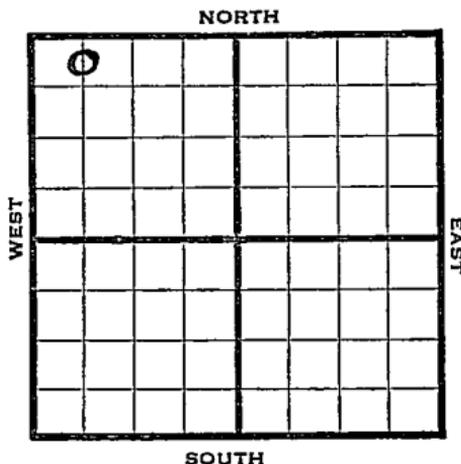

1944

REPORT

4/12

8" @ 515  
- 705'

4/19

Drlg. 2620'

4/26

Lans 3114  
3259 Fsg.

5/3

Arb 3375  
Stains to 3381 TC  
4" @ 3376  
Rust.

5 /10

SWb 161 fluid in 10 hrs  
-10% wtr.

5/17

" "

5/24

" "

5/31

" "

6/7

" "

6/21

Arb. 3375  
4" @ 3376  
T.D. 3381  
Pump 119 oil & 38 Water Pot  
40.1 Gr.

**COMPLETED**

KANSAS

Map No. 5 Sec. 23 Twp. 16 R. 12W

Well No. 2 Riemann

Shell

Company

FIRST REPORT

Contractor

C N L NW NW

SECTION PLAT

0			

330 Ft. from N. Line

\_\_\_\_\_ Ft. from S. Line

\_\_\_\_\_ Ft. from E. Line

660 Ft. from W. Line

Beaver Pool

Location \_\_\_\_\_

Rig up \_\_\_\_\_

Drilling and Remarks:

8" - 515

705'

RECORD

Cased \_\_\_\_\_ in., \_\_\_\_\_ ft.

Sand \_\_\_\_\_

Gas \_\_\_\_\_

Oil \_\_\_\_\_

Total Depth \_\_\_\_\_

PRODUCTION

1st 24 hrs. Nat. \_\_\_\_\_

1st 24 hrs. after shot \_\_\_\_\_

Gas \_\_\_\_\_ Cu. Ft.

Dry Hole \_\_\_\_\_

Abandoned \_\_\_\_\_

Date

APR 12 1944 19

S. J. LEWIS Scout

KANSAS

Pool Name Feltes

Map No. 55 Sec. 23 Twp. 16 R. 12W

Well No. 2 Riemann

Shell Company

**COMPLETED** Contractor

C N L NW NW

SECTION FLAT

330 Ft. from N. Line

\_\_\_\_\_ Ft. from S. Line

\_\_\_\_\_ Ft. from E. Line

660 Ft. from W. Line

0			

Barton County

Location \_\_\_\_\_

Rig up \_\_\_\_\_

Drilling and Remarks:

*Cu 83375*

*# 1103376*

*Pump 119 or 6 + 30 Water*

*out*

*40 1/2 gal*

RECORD

Cased \_\_\_\_\_ in., \_\_\_\_\_ ft.

Sand \_\_\_\_\_

Gas \_\_\_\_\_

Oil \_\_\_\_\_

Total Depth 3381

PRODUCTION

1st 24 hrs. Nat. \_\_\_\_\_

1st 24 hrs. after shot \_\_\_\_\_

Gas \_\_\_\_\_ Cu. Ft.

Dry Hole \_\_\_\_\_

Abandoned \_\_\_\_\_

Date

JUN - 2 1 1944 19

S. I. LEWIS Scout