



Sec. 23 Twp. 16 R. 12W

Well No. #3 Riemann Farm

W. L. Hartman Company

Kraft-Prusa


990 Ft. from N. Line

\_\_\_\_\_ Ft. from S. Line

\_\_\_\_\_ Ft. from E. Line

330 Ft. from W. Line

SW NW SW

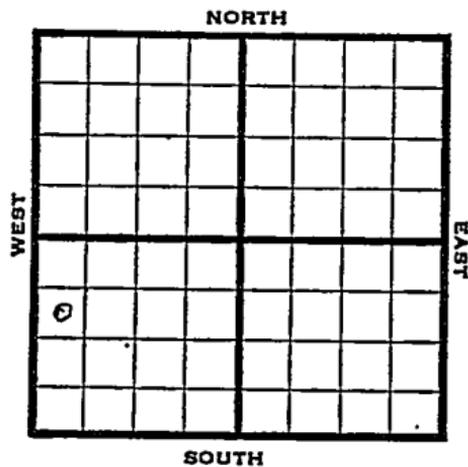

1948

Elev. 1927' REPORT

4/7 RUR

4/14 8" @ 198'  
Drlg. 2375'

4/21 Arbuckle 3370'  
TD 3374'  
5" @ 3370'  
RUST

4/28 "

5/5 "

5/12 TD 3375'

5/19 48 shots 3368 $\frac{1}{2}$ -75 500 acid  $\frac{1}{2}$  B Oil PH  
TD 3378'  
350' water & 1300' oil 12 hrs.

5/26 Arbuckle 3370'  
5" @ 3370'  
500 Acid  
Pump 75 oil Pot.  
Gr. 42.2°  
TD 3378'

**COMPLETED**

Map No. \_\_\_\_\_ Sec. 23 Twp. 16 R. 12WWell No. 3 RiemannW. L. Hartman CompanyFIRST REPORT Contractor

SW NW SW

## SECTION PLAT


990 Ft. from N. Line

\_\_\_\_\_ Ft. from S. Line

\_\_\_\_\_ Ft. from E. Line

330 Ft. from W. LineBarton County

Location \_\_\_\_\_

Rig up \_\_\_\_\_

Drilling and Remarks:

R U R

## RECORD

Cased \_\_\_\_\_ in., \_\_\_\_\_ ft.

Sand \_\_\_\_\_

Gas \_\_\_\_\_

Oil \_\_\_\_\_

Total Depth \_\_\_\_\_

## - PRODUCTION

1st 24 hrs. Nat. \_\_\_\_\_

1st 24 hrs. after shot \_\_\_\_\_

Gas \_\_\_\_\_ Cu. Ft.

Dry Hole \_\_\_\_\_

Abandoned \_\_\_\_\_

Date

APR 7 1948 19S. J. LEWIS Scout

Map No. 55 Sec. 23 Twp. 16 R. 12W

Well No. 3 Riemann

W. L. Hartman Company

**COMPLETE**

Contractor

SW NW SW

E 11927  
SECTION PLAT

990 Ft. from N. Line

\_\_\_\_\_ Ft. from S. Line

\_\_\_\_\_ Ft. from E. Line

330 Ft. from W. Line


Barton County

Location \_\_\_\_\_

Rig up \_\_\_\_\_

Drilling and Remarks:

*CR 73370  
5" @ 3370  
500 acc. c  
Avg. 95 oil ft*

*H. J. Lewis*

RECORD

Cased \_\_\_\_\_ in., \_\_\_\_\_ ft.

Sand \_\_\_\_\_

Gas \_\_\_\_\_

Oil

Total Depth 3278.

PRODUCTION

1st 24 hrs. Nat. \_\_\_\_\_

1st 24 hrs. after shot \_\_\_\_\_

Gas \_\_\_\_\_ Cu. Ft.

Dry Hole \_\_\_\_\_

Abandoned \_\_\_\_\_

Date .

MAY 26 1948 19

**S. J. LEWIS**

Scout