


Section 23 Township 16 Range 12-W

Well No. #1 Riemann

Company Shell

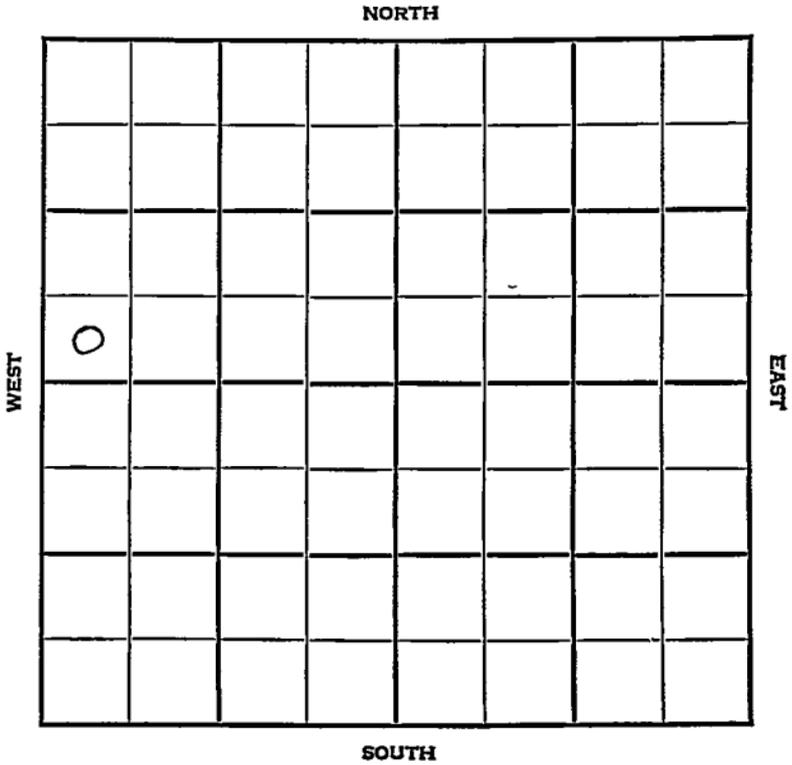

KANSAS

Barton

Sec. 23 Twp. 16 R. 12W

Well No. #4 Riemann Farm

Shell Company

Kraft-Prusa Pool


Ft. from N. Line,

400' Ft. from S. Line

Ft. from E. Line

330' Ft. from W. Line

SW NW

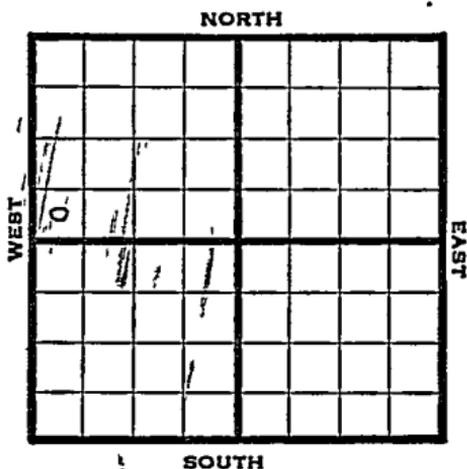

1948

Eli 1934'

REPORT

6/16

RUR

6/23

8" @ 458'  
Drlg 1862'

6/29

Lansing 3100'  
Drlg. 3226'

7/8

Conglomerate 3370'  
Arbuckle 3376'

TD 3378'

4" @ 3377'

3000 acid

swb 160 bbls oil 2 1/2 hrs.

7/14

"

7/21

" -

7/28

Erb. 3376'

4" @ 3377'

TD 3378'

500 acid

Echo Pot 3000 O&I 42° Gr.

Comp.

**COMPLETED**

Map No. \_\_\_\_\_ Sec. 23 Twp. 16 R. 12W

Well No. 4 Riemann

Shell \_\_\_\_\_ Company

### FIRST REPORT

\_\_\_\_\_ Contractor

SW NW

#### SECTION PLAT

\_\_\_\_\_ Ft. from N. Line

400 Ft. from S. Line

\_\_\_\_\_ Ft. from E. Line

330 Ft. from W. Line


Barton County

Location \_\_\_\_\_

Rig up \_\_\_\_\_

Drilling and Remarks:

R U R

#### RECORD

Cased \_\_\_\_\_ in., \_\_\_\_\_ ft.

Sand \_\_\_\_\_

Gas \_\_\_\_\_

Oil \_\_\_\_\_

Total Depth \_\_\_\_\_

#### PRODUCTION

1st 24 hrs. Nat. \_\_\_\_\_

1st 24 hrs. after shot \_\_\_\_\_

Gas \_\_\_\_\_ Cu. Ft.

Dry Hole \_\_\_\_\_

Abandoned \_\_\_\_\_

Date

JUN 16 1948

19

S. J. LEWIS

Scout

Barton County Kansas State

Map No. 55 Sec. 23 Twp. 16 R. 12W

Well No. 4 Riemann

Shell Company

**COMPLETE**

Contractor

SW NW

*E 11934*  
SECTION PLAT


         Ft. from N. Line

400 Ft. from S. Line

         Ft. from E. Line

330 Ft. from W. Line

Kraft-Prusa Pool

Remarks:







Date  
JUL 28 1948

Scout  
S. J. LEWIS