


**KANSAS**

Russell county

Section 16 Township 15 Range 13W

Well No. #3, Meharg


Company Isern Bros.

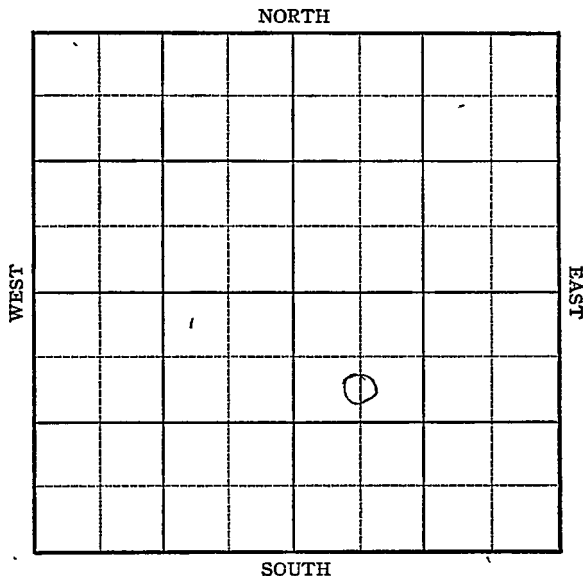

Sec. 16 Twp. 15 R. 13W

Well No. #3 Meharg Farm  
Isern Bros. Company

Trapp  
990 Ft. from N. Line  
Ft. from S. Line  
Ft. from E. Line  
660 Ft. from W. Line  
CSL NW SE

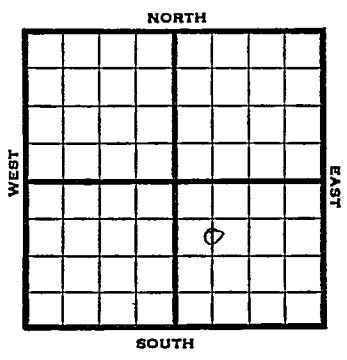

Elev. 1894 REPORT

1946

- 3/20 RUR
- 3/28 8" - 150' Anhy 545'  
Drlg. 2320'
- 4/4 Lans. 3053  
Arb. 3322-3324  
TD 3324  
5" @ 3322 RUST
- 4/10 " " "
- 4/16 " " "
- 4/23 TD 3326  
1500 acid
- 5/1 Arb. 3319  
5" @ 3319  
1000 acid.  
TD 3326  
Pump 56l Pot.  
Grav. 40.0

COMPLETED

KANSAS Kansas Pool Name Trapp  
 Map No. 23 Sec. 16 Twp. 15 R. 13W

Well No. 3 Meharg

Isern Bros. Company

COMPLETED

Contractor

C S L NW SE

*E. 1894*  
SECTION PLAT


990 Ft. from N. Line

\_\_\_\_\_ Ft. from S. Line

\_\_\_\_\_ Ft. from E. Line

660 Ft. from W. Line

Russell County

Location \_\_\_\_\_

Rig up \_\_\_\_\_

Drilling and Remarks:

*Cor 43319*  
*5" @ 33 ft*  
*1000 acid*  
*Pump 56/100*

*40 = 92*

RECORD

Cased \_\_\_\_\_ in., \_\_\_\_\_ ft.

Sand \_\_\_\_\_

Gas \_\_\_\_\_

Oil \_\_\_\_\_

Total Depth 332 6

PRODUCTION

1st 24 hrs. Nat. \_\_\_\_\_

1st 24 hrs. after shot \_\_\_\_\_

Gas \_\_\_\_\_ Cu. Ft.

Dry Hole \_\_\_\_\_

Abandoned \_\_\_\_\_

Date

MAY 1 1946 19

S. J. LEWIS

Scout

**KANSAS** Kansas Pool Name Trapp

Map No. 23 Sec. 16 Twp. 15 R. 13W

Well No. 3 Meharg

Isern Bros. Company

**FIRST REPORT**

Contractor

C S L NW SE

**SECTION PLAT**

		o	

990 Ft. from N. Line

\_\_\_\_\_ Ft. from S. Line

\_\_\_\_\_ Ft. from E. Line

660 Ft. from W. Line

**Russell County**

Location \_\_\_\_\_

Rig up \_\_\_\_\_

Drilling and Remarks:

RUR

**RECORD**

Cased \_\_\_\_\_ in., \_\_\_\_\_ ft.

Sand \_\_\_\_\_

Gas \_\_\_\_\_

Oil \_\_\_\_\_

Total Depth \_\_\_\_\_

**PRODUCTION**

1st 24 hrs. Nat. \_\_\_\_\_

1st 24 hrs. after shot \_\_\_\_\_

Gas \_\_\_\_\_ Cu. Ft.

Dry Hole \_\_\_\_\_

Abandoned \_\_\_\_\_

Date

MAR 20 1946 19

S. J. LEWIS

Scout