

KANSAS


FORM 51 5M 4-41 PETROL

Russell

Section 16 Township 15 Range 13W

Well No. 3 Schultz

Company Isern Bros.

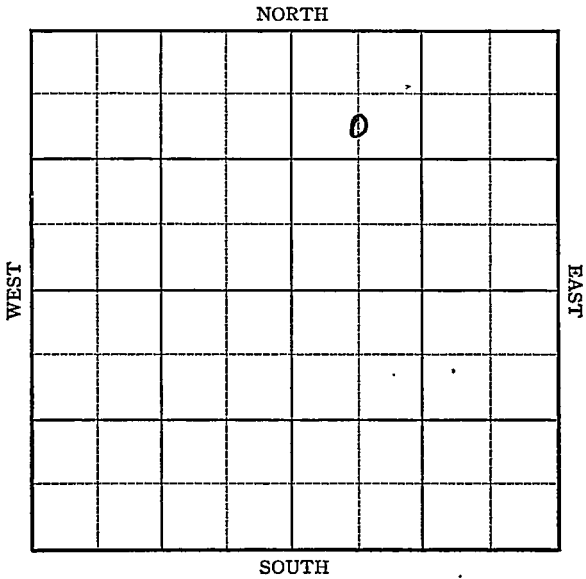

Sec. 16 Twp. 15 R. 13-W

Well No. #3 Schultz Farm

Isern Bros. Company

(Coralena)


990 Ft. from N. Line

_____ Ft. from S. Line

_____ Ft. from E. Line

660 Ft. from W. Line

Elev. 1857

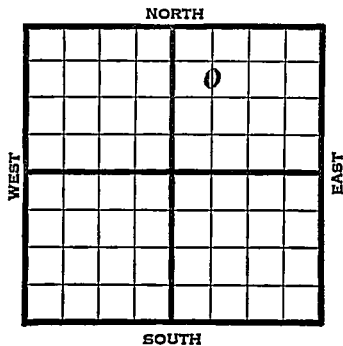

1941	REPORT
6/4	8" - 43'
	Drlg. 1610'
6/12	Lans. 3024' 6" - 3024' RUST.
6/19	T.D. 3075' 200' oil.
6/26	8000 acid. Testing.
7/3	" " " "
7/10	" " " "
7/17	" " " "
	- -
7/23	Lans. 3024'
	6" - 3024'
	T.D. 3075'
	8000 acid.
	Pump 257 oil plus 8 water
	38.2 Gravity
	COMPLETED

Map No. _____ Sec. 16 Twp. 15 R. 13WWell No. 3 SchultzIsern Bros.

Company

Contractor

FIRST REPORT

C S L NW NE

990 Ft. from N. Line

_____ Ft. from S. Line

_____ Ft. from E. Line

660 Ft. from W. Line

SECTION PLAT

		o	

CORALENA POOL

Location _____

Rig up _____

Drilling and Remarks:

8" - 43'Dr lg. 1610

RECORD

Cased _____ in., _____ ft.

Sand _____

Gas _____

Oil _____

Total Depth _____

PRODUCTION

1st 24 hrs. Nat. _____

1st 24 hrs. after shot _____

Gas _____ Cu. Ft.

Dry Hole _____

Abandoned _____

Date

JUN 4 1941 19S. J. LEWIS Scout

Map No. _____ Sec. 16 Twp. 15 R. 13W

Well No. 3 Schultz

Isern Bros. Company

~~COMPLETED~~ Contractor

SECTION PLAT

		o	

C S L NW NE

990 Ft. from N. Line

_____ Ft. from S. Line

_____ Ft. from E. Line

660 Ft. from W. Line

CORALENA POOL

RECORD

Location _____

Cased _____ in., _____ ft.

Rig up _____

Sand _____

Drilling and Remarks:

Gas _____

Oil _____

Total Depth 3075'

Lions 3024

6" C 3024

7000 Gall

Pump 257 oil + 5 Water

P.F.

382 gal

PRODUCTION

1st 24 hrs. Nat. _____

1st 24 hrs. after shot _____

Gas _____ Cu. Ft.

Dry Hole _____

Abandoned _____

Date

JUL 23 1941 19

S. J. LEWIS Scout