

KANSAS


FORM 51 5M 6-46 PETROL

Russell County

Section 16 Township 15 Range 13W

Well No. #5 Neharg

Company E. W. Wakefield

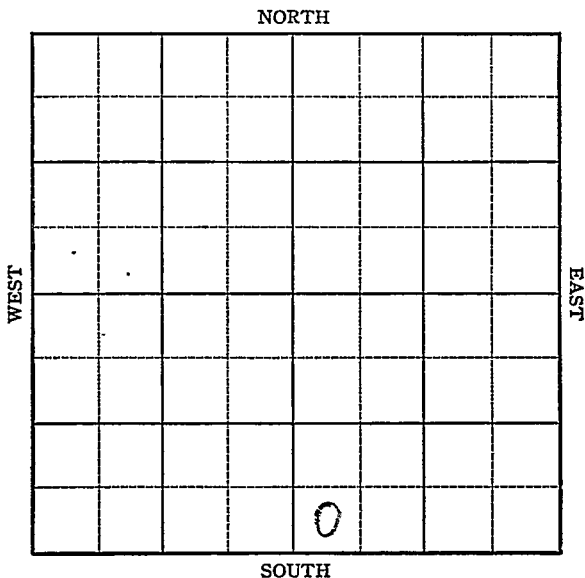

KANSAS

Russell County ✓

Sec. 16 Twp. 15 R. 13W

Well No. #5 Neharg Farm
E. W. Wakefield Company


Trapp

_____ Ft. from N. Line

330 Ft. from S. Line

_____ Ft. from E. Line

330 Ft. from W. Line

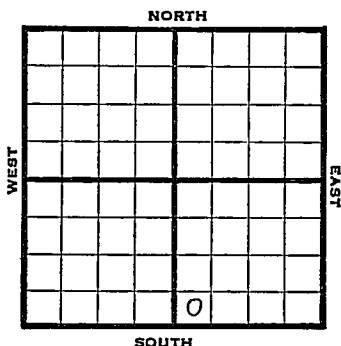

SW SE

1946

1887

REPORT

7/24 8" @ 561' WOC

7/30 Anhy 855
Drlg 2590'

8/6 Arb 3340-
3342 TD
SO 5" @ 3341 RUST

8/13 1500' oil 10 hrs
500 acid

8/20 Pump 7 Oil PH 2 hrs

8/27 " " "

9/5 Arb. 3340'
5" @ 3341'
500. acid
Pump 150 Pot.
T.D. 3342'
40.4 Gravity

COMPLETED

KANSAS Pool Name Trapp
Kansas

Map No. 73 Sec. 16 Twp. 15 R. 13W

Well No. 5 Meharg

E. W. Wakefield Company

COMPLETED

Contractor

SW SE

E 11887
SECTION PLAT

_____ Ft. from N. Line

330 Ft. from S. Line

_____ Ft. from E. Line

330 Ft. from W. Line

Russell County

RECORD

Location _____

Cased _____ in. _____ ft.

Rig up _____

Sand _____

Drilling and Remarks:

Gas _____

Ar 8340
5" @ 8341
500 acid
Pump 130 B

Oil _____

Total Depth 8342

PRODUCTION

1st 24 hrs. Nat. _____

1st 24 hrs. after shot _____

Gas _____ Cu. Ft.

Dry Hole _____

Abandoned _____

40 7/8

Date

SEP 5 1946 19 S. J. LEWIS Scout