

Section 23 Township 16 Range 12W

Well No. 4 Riemann

Company W L Haftman

Kraft-Prusa  
NORTH


WEST

EAST

SOUTH

0

Sec. 23 Twp. 16 R. 12-W ✓

Well No. #4 Riemann Farm


W L Hartman Company

\_\_\_\_\_ Ft. from N. Line

990 Ft. from S. Line

\_\_\_\_\_ Ft. from E. Line

330 Ft. from W. Line

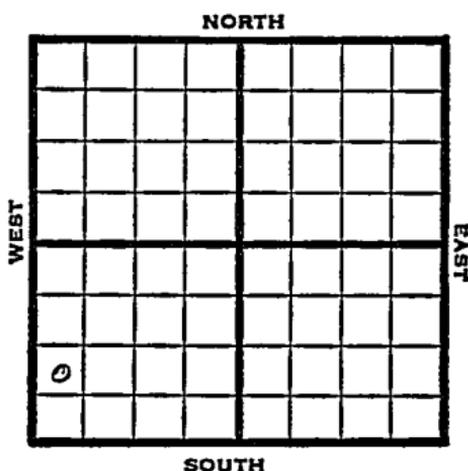

NW SW SW

1949	Elev 1925' REPORT
1/26	8" @ 158' Drlg 1725'
2/2	Lansing 3095' Reagan 3361' TD 3365' 5" @ 3362'
2/9	Lansing 3095' Reagan 3361-65' TD 3365' 5" @ 3362'
2/16	"
2/23	TD 3367'
	365' oil
3/2	"
3/8	10 qts
	Pump 1 bbl oil PH 24 hrs.
	200 acid
3/16	10 qts. CO
3/23	150' oil SW
3/30	Pump 8 bbls oil 3 hrs.
4/6	TD 3367'
	Reagan 3361'
	5" @ 3362'
	Pump 25 oil Pot
	42° Gr.
	Gomp
	<b>COMPLETED</b>

Map No. \_\_\_\_\_ Sec. 23 Twp. 16 R. 12W

Well No. 4 Riemann

W. L. Hartman Company

**FIRST REPORT** Contractor

N<sup>W</sup> SW SW

**SECTION PLAT**

\_\_\_\_\_ Ft. from N. Line

990 Ft. from S. Line

\_\_\_\_\_ Ft. from E. Line

330 Ft. from W. Line


Barton County

Location \_\_\_\_\_

Rig up \_\_\_\_\_

Drilling and Remarks:

8" C 158

drlg. 1725

**RECORD**

Cased \_\_\_\_\_ in., \_\_\_\_\_ ft.

Sand \_\_\_\_\_

Gas \_\_\_\_\_

Oil \_\_\_\_\_

Total Depth \_\_\_\_\_

**PRODUCTION**

1st 24 hrs. Nat. \_\_\_\_\_

1st 24 hrs. after shot \_\_\_\_\_

Gas " \_\_\_\_\_ Cu. Ft.

Dry Hole \_\_\_\_\_

Abandoned \_\_\_\_\_

Date

JAN 26 1949 19

S. J. LEWIS Scout

