


Section 16 Township 15 Range 13-W

Well No. 1 Seigfried

Company Coralena

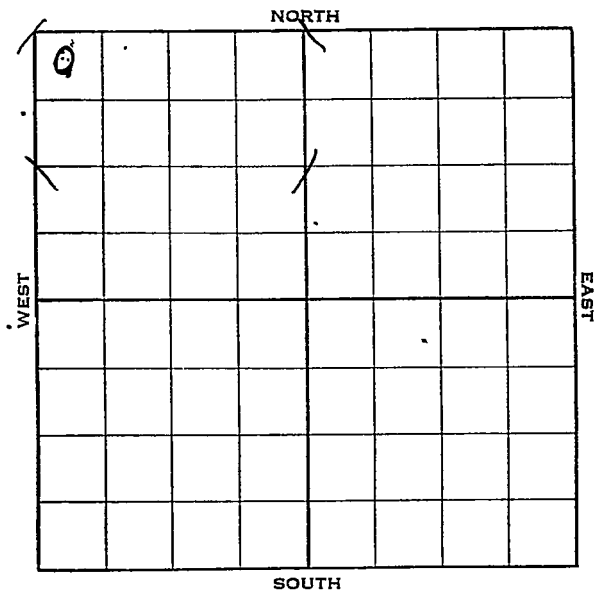

Sec. 16 Twp. 15 R. 13-W

Well No. #1 Seigfried Farm


Coraleena Company

330 Ft. from N. Line

_____ Ft. from S. Line

_____ Ft. from E. Line

330 Ft. from W. Line

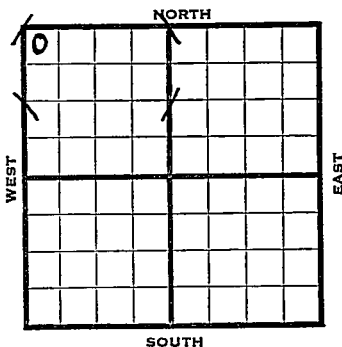

Elev. 1887'.

1938	REPORT
9/14	R U R
9/23	13" - 146'. Anhy 840'.
	Dlg. 852'.
9/30	Topeka 2755'. Dlg. 2800'.
10/7	Lans. 3054'. S.S.O. 3081-86'. 8" - 3079'. RUST.
10/12	Lans: 3054'.
	S. O. 3081-86'. D.
	8" - 3079'. Csg. collapsed.
	Skid rig.
	ABANDONED

Russell

KANSAS

Map No. 73 Sec. 16 Twp. 15 R. 13WWell No. I SeigfriedCoralena

Company

Contractor

Shell F.O.FIRST REPORT
NW/C

SECTION PLAT

0			

330 Ft. from N. Line

_____ Ft. from S. Line

_____ Ft. from E. Line

330 Ft. from W. Line

Location _____

Rig up _____

Drilling and Remarks:

RUR

RECORD

Cased _____ in., _____ ft.

Sand _____

Gas _____

Oil _____

Total Depth _____

PRODUCTION

1st 24 hrs. Nat. _____

1st 24 hrs. after shot _____

Gas _____ Cu. Ft.

Dry Hole _____

Abandoned _____

Date

SEP 14 1938

19

H. D. Hatfield

Scout

Map No. _____ Sec. 16 Twp. 15 R. 13W

Well No. 1 Seigfried

Coralena

Company _____

Contractor _____

ABANDONED
NW/C

SECTION PLAT

330 Ft. from N. Line

_____ Ft. from S. Line

_____ Ft. from E. Line

330 Ft. from W. Line

0			

Location _____

RECORD

Rig up _____

Cased _____ in., _____ ft.

Drilling and Remarks:

Sand _____

Gas _____

Oil _____

Total Depth _____

PRODUCTION

1st 24 hrs. Nat. _____

1st 24 hrs. after shot _____

Gas _____ Cu. Ft.

Dry Hole _____

Abandoned _____

*LENS 3054 S.O.
3081-86 T.D. 8"-3079*

CSG collapsed

D & A

Skid Rig

Date

OCT 12 1938

19

H. D. Hatfield

Scout