

Map No. Kaw Sec. 21 Twp. 33 R. 3

Well No. 7 C Nelson Farm


Waite Phillips Company

_____ Ft. from N. Line

330 Ft. from S. Line

_____ Ft. from E. Line

330 Ft. from W. Line

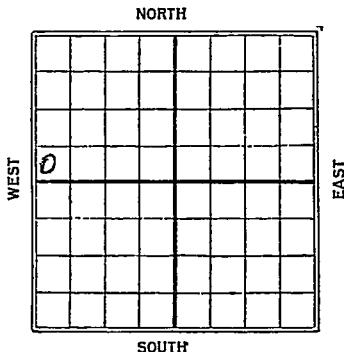

Date	REPORT
1925	
6/15	<u>Location</u>
<u>6/15</u>	<u>860</u>
<u>7/22</u>	<u>U.R. 8" - T.D. 2290.</u>
<u>7/29</u>	<u>27 80'</u>
<u>8/17</u>	<u>3115'</u>
<u>8/12</u>	<u>and 3197-3220' T.D.</u>
	<u>1139 bbls Nat.</u>

KANSAS
 Map No. _____ Sec. 21 Twp. 33 R. 2
 Well No. 7 E Nelson
Wart Phillips Company
 Contractor

FIRST REPORT

SECTION PLAT

_____ Ft. from N. Line

330 Ft. from S. Line

_____ Ft. from E. Line

330 Ft. from W. Line

0			

Location ✓✓

Rig up _____

Drilling and Remarks:

RECORD

Cased _____ in., _____ ft.

Sand _____

Gas _____

Oil _____

Total Depth _____

PRODUCTION

1st 24 hrs. Nat. _____

1st 24 hrs. after shot _____

Gas _____ Cu. Ft.

Dry Hole _____

Abandoned _____

Date

MAY 5 1925

192

M. A. BENEAR

Scout

Map No. KANSAS Sec. 21 Twp. 33 R. 3E

Well No. 7 Nelson

Haute Phillips Company

Contractor

COMPLETED

SECTION PLAT

-----Ft. from N. Line

330 Ft. from S. Line

-----Ft. from E. Line

330 Ft. from W. Line

o			

Location -----

Rig up -----

Drilling and Remarks:

RECORD

Cased ----- in., ----- ft.

Sand 3197 - 3230

Gas -----

Oil -----

Total Depth 3230

PRODUCTION

1st 24 hrs. Nat. 1139

1st 24 hrs. after shot -----

Gas ----- Cu. Ft.

Dry Hole -----

Abandoned -----

Date

AUG 12 1925

S. J. LEWIS

Scout