

Form 51-5M-7-39-Palace

KANSAS

NORTH

TRAPP
Coralena Pool

WEST

EASY

SOUTH

KANSAS

Russell

O.W.W.O. ✓

Sec. 17 Twp. 15 R. 13-WWell No. #5 J. W. Meharg FarmContinental


Company

~~(Coralena)~~ TRAPP

Ft. from N. Line

990 Ft. from S. Line

Ft. from E. Line

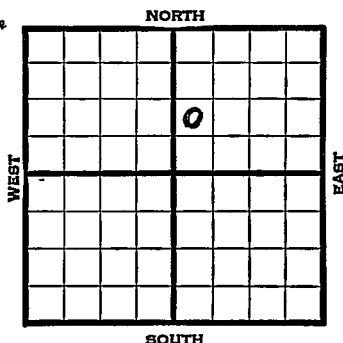330 Ft. from W. LineNE $\frac{1}{4}$ NW SW NE

1939	Elev. 1792' REPORT
8/16	Rotary.
8/24	10" - 110' Drlg. 195'
8/31	Drlg. 2905'
9/7	Arb. 3213' 7" - 3214'
	T.D. 3216' RUST.
9/14	T.D. 3226' 2800' oil 2 hours.
9/20	Arb. 3213'
	7" - 3214'
	T.D. 3226'
	Pump 2088 bbls.
	COMPLETED
	O.W.W.O.
1952	
11/12	Lans 2950', Arb 3213'
	OTD 3226'
	7" @ 3214'
	PB 3170
	24/3124-30, 500A
	B $\frac{1}{4}$ boph 1000A
	S/ 1/3 boph SP 3100
	OVER

1952

11/20 48/2988-3000 24/2972-78
B/1/2 BOPH 5 hrs. 1000 A
S/2 BOPH plus trace S/45 BO plus
trace 10 hrs.
11/27 P/6 BO 6 hrs.

12/4 NR

12/11 NR

12/18 P/8 BO 6 Hrs.

12/25 " " "

1/1 NR

1/8 NR

1/22 NR

1/29 "

2/5 NR

2/12 NR

2/19 NR

2/25 Oil well TD 3226 Lans. 2950'
Arb. 3213 . OTD 3226 7" @ 3214
PB 3170 24/3124-30 500 A
B/1/4 BOPH 1000 A S/1/3 BOPH SP 3100
48/2988-3000 24/2972-78 . B/1/2 BOPH
5 hr. 1000 A S/2 BOPH
S/45 BO 10 hr. P/6 BO 6 hr.
P/8 BO 6 hr. P/4 1/2 BO 6 hr..
Comp. 17 BOPD

COMPLETED

Russell KANSAS

Map No. 73 Sec. 17 Twp. 15 R. 13WWell No. 5 J.W. MehargContinental

Company

Contractor

FIRST REPORT

NW SW NE

Ft. from N. Line

990 Ft. from S. Line

Ft. from E. Line

330 Ft. from W. Line

CORALENA POOL

SECTION PLAT

		o	

Location

Rig up

Drilling and Remarks:

Rotary

RECORD

Cased _____ in., _____ ft.

Sand _____

Gas _____

Oil _____

Total Depth _____

PRODUCTION

1st 24 hrs. Nat. _____

1st 24 hrs. after shot _____

Gas _____ Cu. Ft.

Dry Hole _____

Abandoned _____

Date

AUG 16 1939 19

S. J. LEWIS Scout

Map No. _____ Sec. 17 Twp. 15 R. 13WWell No. 5 J. W. MehargContinental

Company

Contractor

COMPLEVEL

NW SW NE

SECTION PLAT

		o	

_____ Ft. from N. Line

990 Ft. from S. Line

_____ Ft. from E. Line

330 Ft. from W. Line**CORALENA POOL**

Location _____

Rig up _____

Drilling and Remarks:

*Gr. 8213**7" @ 3214**Pump 2088***RECORD**

Cased _____ in., _____ ft.

Sand _____

Gas _____

Oil _____

Total Depth 3226**PRODUCTION**

1st 24 hrs. Nat. _____

1st 24 hrs. after shot _____

Gas _____ Cu. Ft.

Dry Hole _____

Abandoned _____


Date

SEP 20 1939 19S. J. LEWIS Scout

J. G. McGEHEE

O.W.W.O.

County Russell State Kansas
 Sec. 17 (Blk. 15 (Sur. 13W Map No.
 Twp.) (Rge.)
 Operator Continental Oil
 Well No. 5 Farm Meharg
 Elev. 1792 Location NW SW NE

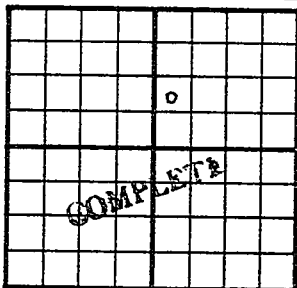

990 Ft. From S Line NE

330 Ft. From W Line Quarter

1st. Report

Completion FEB 25 1953

Remarks OWWO

Spudding Date

O.W.W.O.

Drlg. Data Oil well TD 3226
 Lans. 2950 Arb. 3213 OTD 3226
 7" @ 3214 PB 3170 24/ 3124-30 500 A
 B/ $\frac{1}{4}$ boph 1000 A S/ $\frac{1}{3}$ boph SP 3100
 48/ 2988-3000 24/ 2972-78 B/ $\frac{1}{2}$ boph
 5 hr. 1000 A S/ 2 boph S/ 45 bo 10 hr.
 P/ 6 bo 6 hr. P/ 8 bo 6 hr.
 P/ $4\frac{1}{2}$ bo 6 hr. Comp. 17 bopd

J. G. McGEHEE