


Section 17 Township 15 Range 13-W

Well No. #6 J. W. Meharg

Company Continental

NORTH **Coralena Pool**

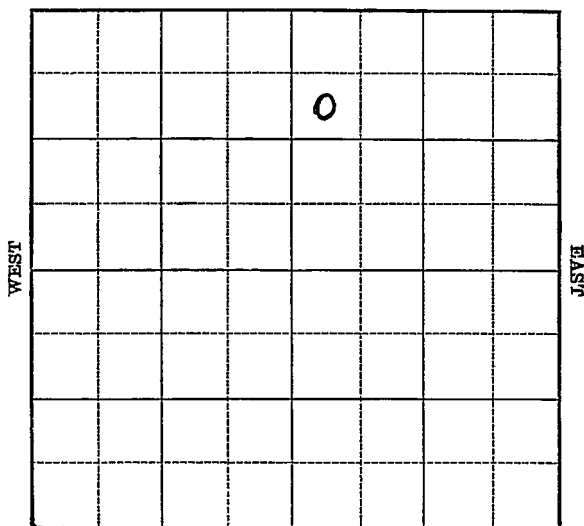

SOUTH

Sec. 17 Twp. 15 R. 13-W

Well No. #6 J. W. Meharg Farm

Continental Company


(Coralena)

990 Ft. from N. Line

\_\_\_\_\_ Ft. from S. Line

\_\_\_\_\_ Ft. from E. Line

330 Ft. from W. Line

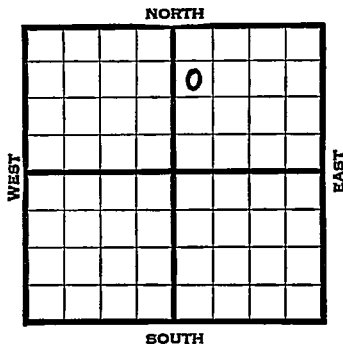

1939	REPORT
8/16	Rotary.
8/24	"
8/31	"
9/7	10" - 475' WOC.
9/14	Drlg. 2609'
9/21	Arb. 3230' 7" - 3231' T.D.
	RUST.
9/28	T.D. 3241' 2900' oil.
10/4	Arb. 3230'
	7" - 3231'
	T.D. 3241'
	Potential 2592 bbls., pump.
	<b>COMPLETED</b>

Map No. 73 Sec. 17 Twp. 15 R. 13W

Well No. 6 J. W. Meharg

Continental

Company

Contractor

**FIRST REPORT**

SW NW NE

**SECTION PLAT**

		o	

990 Ft. from N. Line

\_\_\_\_\_ Ft. from S. Line

\_\_\_\_\_ Ft. from E. Line

330 Ft. from W. Line

**CORALENA POOL**

Location \_\_\_\_\_

Rig up \_\_\_\_\_

Drilling and Remarks:

**Rotary**

**RECORD**

Cased \_\_\_\_\_ in., \_\_\_\_\_ ft.

Sand \_\_\_\_\_

Gas \_\_\_\_\_

Oil \_\_\_\_\_

Total Depth \_\_\_\_\_

**PRODUCTION**

1st 24 hrs. Nat. \_\_\_\_\_

1st 24 hrs. after shot \_\_\_\_\_

Gas \_\_\_\_\_ Cu. Ft.

Dry Hole \_\_\_\_\_

Abandoned \_\_\_\_\_

Date

**AUG 16 1939**

**S. J. LEWIS**

19

Scout

Map No. \_\_\_\_\_ Sec. **17** Twp. **15** R. **13W**

Well No. **6 J. W. Meharg**

**Continental**

Company

Contractor

**COMPLETED**

SW NW NE

**SECTION PLAT**

**990** Ft. from N. Line

		o	

\_\_\_\_\_ Ft. from S. Line

\_\_\_\_\_ Ft. from E. Line

**330** Ft. from W. Line

**CORALENA POOL**

Location \_\_\_\_\_

**RECORD**

Rig up \_\_\_\_\_

Cased \_\_\_\_\_ in., \_\_\_\_\_ ft.

Drilling and Remarks:

Sand \_\_\_\_\_

*Core 3230*

Gas \_\_\_\_\_

*7" @ 3231*

Oil \_\_\_\_\_

*Pump 2592 P.S.*

Total Depth 3241

**PRODUCTION**

1st 24 hrs. Nat. \_\_\_\_\_

1st 24 hrs. after shot \_\_\_\_\_

Gas \_\_\_\_\_ Cu. Ft.

Dry Hole \_\_\_\_\_

Abandoned \_\_\_\_\_

Date

**OCT 4 1939** 19

**S. J. LEWIS** Scout