


Cowley

Map No. Kansas Sec. 21 Twp. 33 R. 3E

Well No. 18 E. Nelson Farm
Wate Phillips Company

NORTH

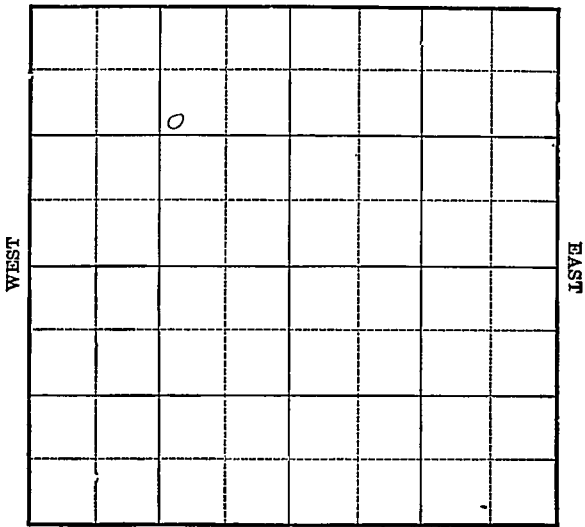

SOUTH

Location _____

Drilling Remarks _____

RECORD

Cased _____ in. _____ ft.

Sand _____

Gas _____

Oil _____

Total Depth _____

Rig Up _____

Drilling Remarks _____

PRODUCTION

1st 24 hrs. Nat. _____

1st 24 hrs. after shot _____

Gas _____ cu. ft.

Dry Hole _____

Abandoned _____

Map No. Kansas Sec. 21 Twp. 33 R. 3^E

Well No. 18 E Nelson Farm
Waite Phillips Company


NORTH

405 Ft. from N. Line

..... Ft. from S. Line

..... Ft. from E. Line

1713 Ft. from W. Line

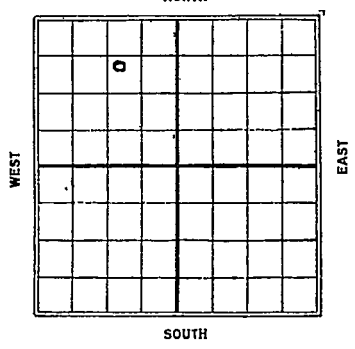

1996

REPORT

<u>1/3</u>	<u>Rig Bldg.</u>		
<u>4/14</u>	<u>Top sand 3202</u>	<u>T.D. 3229</u>	
	<u>125 bbls mah</u>		

Map No. 11513 Sec. 21 Twp. 33 R. 3E

Well No. 18 E. Nelson

Route Phillips Company

Contractor

SECTION PLAT

	0		

405 Ft. from N. Line

----- Ft. from S. Line

----- Ft. from E. Line

1713 Ft. from W. Line

FIRST REPORTS

Location -----

Rig up -----

Drilling and Remarks:

Rig Blow

RECORD

Cased ----- in., ----- ft.

Sand -----

Gas -----

Oil -----

Total Depth -----

PRODUCTION

1st 24 hrs. Nat. -----

1st 24 hrs. after shot -----

Gas ----- Cu. Ft.

Dry Hole -----

Abandoned -----

Date

JAN 13 1926

S. J. LEWIS

K. Cowley
 Map No. **KANSAS** Sec. *21* Twp. *33* R. *3E*

Well No. *18 E Nelson*

Walter Phillips Company

Contractor

SECTION PLAT

405 Ft. from N. Line

.....Ft. from S. Line

.....Ft. from E. Line

1713 Ft. from W. Line

	<i>0</i>		

COMPLETED

Location

Rig up

Drilling and Remarks:

TS 3202.
TH 3229 in
sand
125 Hls Nat.

RECORD

Cased.....in.,ft.

Sand

Gas

Oil.....

Total Depth.....

PRODUCTION

1st 24 hrs. Nat.

1st 24 hrs. after shot.....

Gas.....Cu. Ft.

Dry Hole.....

Abandoned.....

Date

APR 14 1926

S. J. LEWIS

Scout