

KANSAS


Russell

FORM 51 5M 4-41 PETROL

Section 17 Township 15 Range 13W

Well No. 10 Meharg

Company Continental

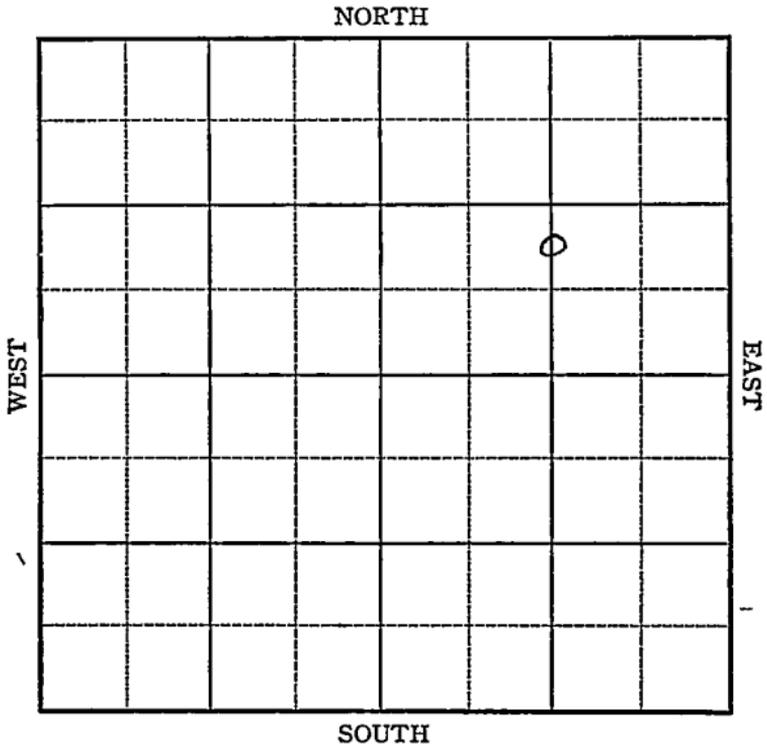

Map No. _____ Sec. 17 Twp. 15 R. 13W

Well No. 10 Meharg

Continental Company

Contractor

FIRST REPORT

SECTION PLAT

C N L S $\frac{1}{2}$ NE
Ft. from N. Line

990 Ft. from S. Line

1320 Ft. from E. Line

_____ Ft. from W. Line

			o

CORALENA POOL

RECORD

Location _____

Cased _____ in., _____ ft.

Rig up _____

Sand _____

Drilling and Remarks:

Gas _____

Derrick

Oil _____

Total Depth _____

PRODUCTION

1st 24 hrs. Nat. _____

1st 24 hrs. after shot _____

Gas _____ Cu. Ft.

Dry Hole _____

Abandoned _____

Date

JUN 25 1941 19

S. J. LEWIS Scout

Map No. 73 Sec. 17 Twp. 15 R. 13W

Well No. 10 Meharg

Continental Company

COMPLETED Contractor

C N L S $\frac{1}{2}$ NE

SECTION PLAT

 Ft. from N. Line

990 Ft. from S. Line

1320 Ft. from E. Line

 Ft. from W. Line

		o	

CORALENA POOL

Location

Rig up

Drilling and Remarks:

Cu #3279
6" @ 3280
2000 acid
Echo # 1713 Oil
129 Water

38³ Gr

RECORD

Cased in., ft.

Sand

Gas

Oil

Total Depth 3288

PRODUCTION

1st 24 hrs. Nat.

1st 24 hrs. after shot

Gas Cu. Ft.

Dry Hole

Abandoned

Date

JUL 16 1941 19

S. J. LEWIS Scout